

CERTIFIED LAND CORNER RESTORATION

Index No. M-13

State of Wisconsin }
County of Lincoln } ss.

History of original corner establishment:

Date: 10 January 1855
Surveyor: Jackson L. Prentice
Monumentation: Wood Post
Witnesses: 10" Tamarack, S 86° W, 19 links
14" Spruce, N 21° W, 48 links
14" Pine, S 61° E, 44 links

I Lester J. Schmit, do hereby certify that on the 28th day of February, 19 81, I found evidence of the Southeast corner of Section 16 Township 34, North, Range 5 East, Fourth, Principal Meridian, as described hereon; and that from this evidence I established a new monument and accessories as described hereon to perpetuate the original location of this corner.

Description of corner evidence found: I found a 2" iron pipe, 64" long for the corner. This pipe was set by Joseph Scholz, assistant of Francis Fox, County Land Surveyor, in the early 1940's. Mr. Fox had a wood stake at this location to mark the Southeast corner of Section 16. Mr. Scholz replaced it with the iron pipe, upon request of Mr. Fox.


Resident witnesses:

Joseph Scholz

Description of monument and accessories I established to perpetuate the original location of this corner.

30" Berntsen monument top set 4" above surface of ground.
North Branch of Armstrong Creek is 72' southerly of corner.

Witnesses: P.K. nail in 4" Soft Maple, N 3° E, 30.61'
P.K. nail in 6" White Birch, N 73° E, 17.94'
P.K. nail in 7" Aspen, S 8° E, 10.43'
P.K. nail in 7" Cherry, N 41° W, 4.64'

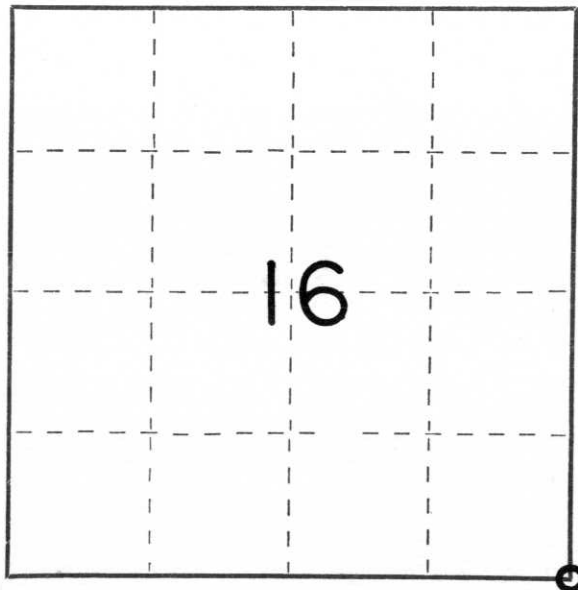

○ = Corner monument restored.

Dated at Tomahawk, Wis., this 23rd day of April, 1981

Signature Lester J. Schmit Title Registered Land Surveyor Registration No. S-1192
(County Surveyor, Registered Land Surveyor, or other duly authorized official)

Office of Register of Deeds, County of _____, I hereby certify that the within instrument was filed in this office for record on the _____ day of _____, 19____ at _____ o'clock _____ M.

(Register of Deeds)

By _____ Deputy

T34N

15/14
22/23

R5E







