

CERTIFIED LAND CORNER RESTORATION


Index No. M-11

State of Wisconsin }  
County of Lincoln } ss.

I Lester J. Schmit, do hereby certify that on the 22nd day of April, 1981, I ~~found~~ set the ~~evidence of the~~ South 1/4 corner of Section 16 Township 34, North, Range 5 East, Fourth, Principal Meridian, as described hereon; and that from this evidence I established a new monument and accessories as described hereon to perpetuate the original location of this corner.

Resident witnesses:

.....  
.....  
.....

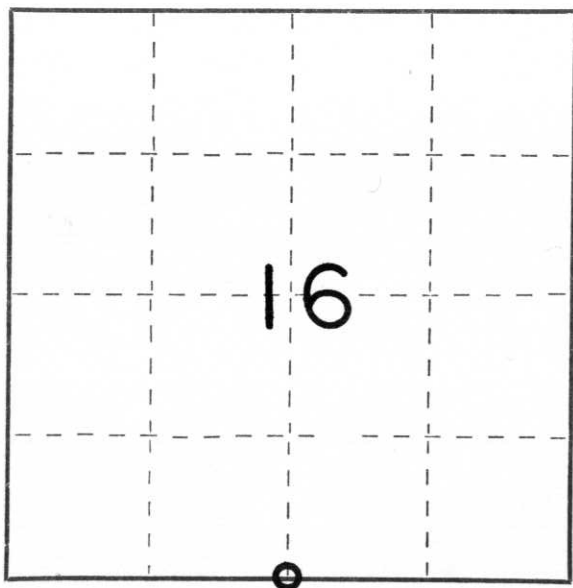

○ = Corner monument restored.

History of original corner establishment:

Date: 11 January 1855  
Surveyor: Jackson L. Prentice  
Monumentation: Wood Post  
Witnesses: 16" Pine, S 63° W, 28 links  
10" Pine, N 41° E, 41 links

Description of corner evidence found: I found no evidence of either the corner or the original bearing tress or their stumps. Original notes call for the south line of the section to be 5273.40'. A resurvey of this south line, I find the distance to be 5264.50'. I therefore set a Lincoln County Berntsen Monument on a straight line at 2632.25' from the Southeast and Southwest corners of Section 16.

Description of monument and accessories I established to perpetuate the original location of this corner.  
30" Berntsen monument top is set 3" above surface of ground.

Witnesses: P.K. nail in 5" Sugar Maple, N 73° E, 10.87'  
P.K. nail in 4" Sugar Maple, S 17° E, 4.32'  
P.K. nail in 4" Ironwood, N 75° W, 9.83'  
P.K. nail in 7" Sugar Maple, N 19° W, 15.61'

Dated at Tomahawk, Wis., this 23rd day of April, 1981

Signature Lester J. Schmit Title Registered Land Surveyor Registration No. S-1192  
(County Surveyor, Registered Land Surveyor, or other duly authorized official)

Office of Register of Deeds, County of....., I hereby certify that the within instrument was filed in this office for record on the.....day of....., 19..... at.....o'clock..... M..

.....  
(Register of Deeds)

By.....Deputy