

CERTIFIED LAND CORNER RESTORATION

Index No. M-9

State of Wisconsin }  
County of Lincoln } ss.

I Lester J. Schmit, do hereby certify that on the 15th day of April, 1981, I ~~found~~ found evidence of the set the Southwest corner of Section 16 Township 34, North, Range 5 East, Fourth, Principal Meridian, as described hereon; and that from this evidence I established a new monument and accessories as described hereon to perpetuate the original location of this corner.

Resident witnesses:

Joseph Scholz  
.....  
.....

History of original corner establishment:


Date: 11 January 1855  
Surveyor: Jackson L. Prentice  
Monumentation: Wood Post  
Witnesses: 14" Pine, N 29° E, 15 links  
12" Pine, N 9° W, 51 links  
10" Pine, S 82° W, 25 links  
12" Pine, S 62° E, 50 links

Description of corner evidence found: I found no evidence of either the corner or the original bearing trees or their stumps. From a long time local resident, Joseph Scholz, I was told that a very old fence line west of the corner was started from the corner. From this information, I set a Lincoln County Berntsen Monument at the intersection of the fence line and the centre-line of Faust Road from the north. Original notes call for the west line of the section to be 5280.00'. A resurvey of this west line, I find the distance to be 5283.36'.

Description of monument and accessories I established to perpetuate the original location of this corner.

30" Berntsen monument top set 6" below the surface of Faust Road.

Witnesses: P.K. nail in 11" White Birch, N 70° E, 32.55'  
P.K. nail in 7" Soft Maple, S 34° E, 46.68'  
P.K. nail in 7" White Birch, S 33° W, 38.07'  
P.K. nail in 8" White Birch, N 88° W, 50.61'

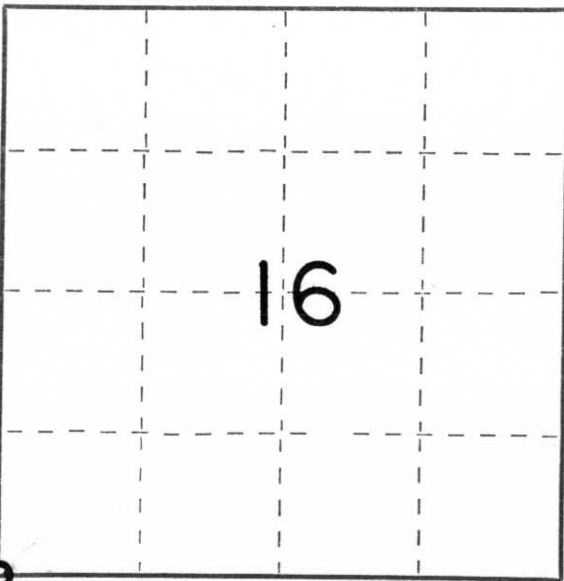

○ = Corner monument restored.

Dated at Tomahawk, Wis., this 23rd day of April, 1981.

Signature Lester J. Schmit Title Registered Land Surveyor Registration No. S-1192  
(County Surveyor, Registered Land Surveyor, or other duly authorized official)

Office of Register of Deeds, County of \_\_\_\_\_, I hereby certify that the within instrument was filed in this office for record on the \_\_\_\_\_ day of \_\_\_\_\_, 19\_\_\_\_ at \_\_\_\_\_ o'clock \_\_\_\_\_ M.

.....  
(Register of Deeds)

By \_\_\_\_\_ Deputy