


85.

Project I.D. 1175-3-00 C.T.H. "S"
U.S.H.8 U.S.H. 51 Freeway Lincoln
Co. Wm. Scherer Surveyor Received
from Division of Hwy's Jan. 11, 1973

T34N

R 6 1/2 E L-25

Oct. 22, 1971

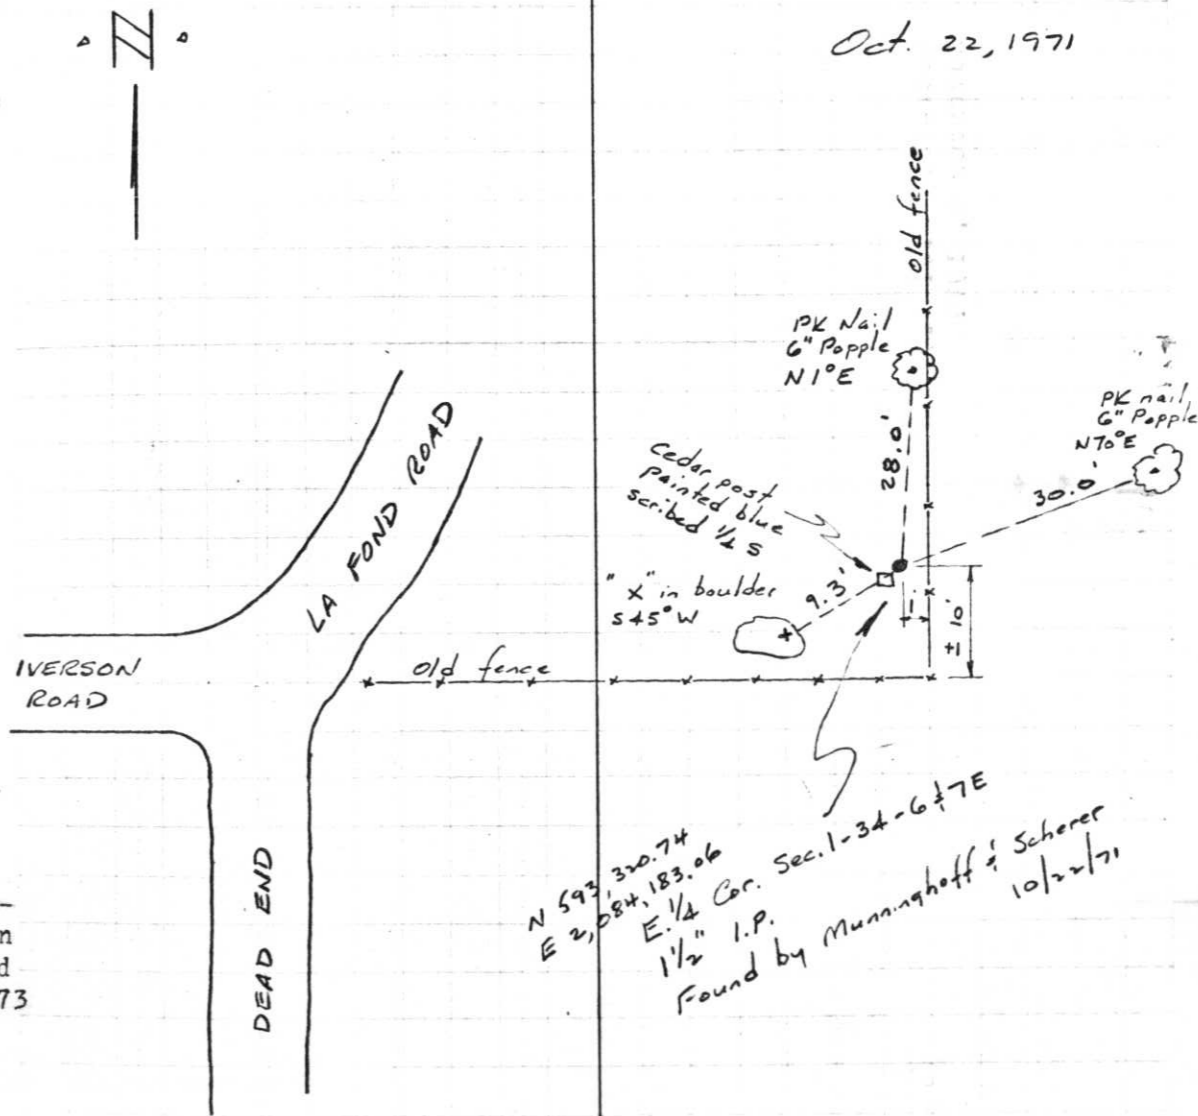

N 59° 32' 30.74
E 21° 08' 183.06
1/2" I.P.
Found by Munninghoff & Scherer
10/22/71


85.

Project I.D. 1175-3-00 C.T.H. "S"
U.S.H. 8 U.S.H. 51 Freeway Lincoln
Co. Wm. Scherer Surveyor Received
from Division of Hwy's Jan. 11, 1973

T34N

R 6 1/2 E L-25

Oct. 22, 1971

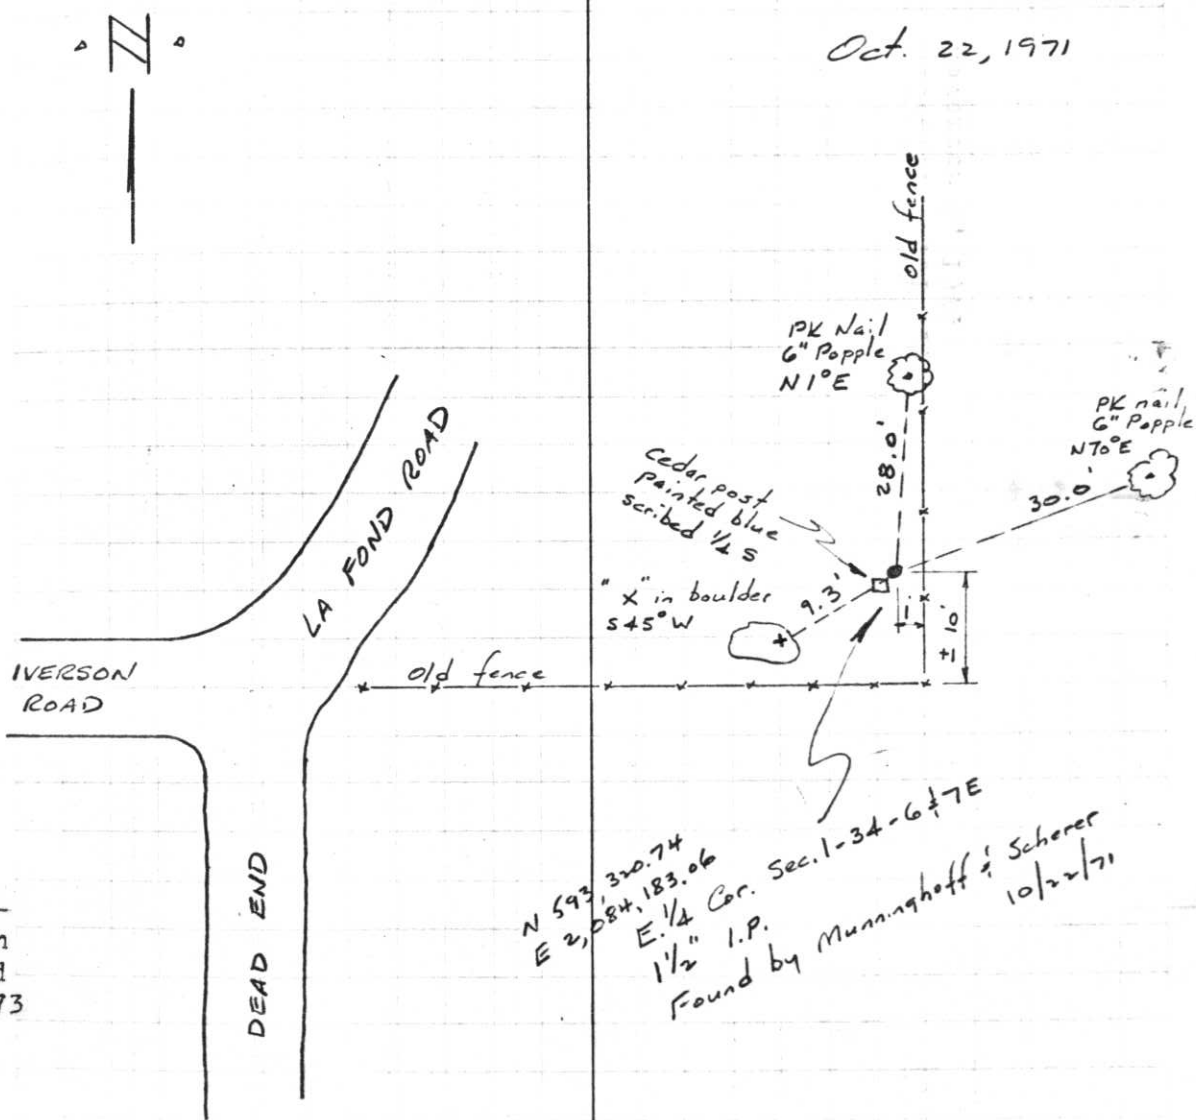


85.

Project I.D. 1173-3-00 C.T.H. "S"
U.S.H.8 U.S.H. 51 Freeway Lincoln
Co. Wm. Scherer Surveyor Received
from Division of Hwy's Jan. 11, 1973

T34N

R6 1/2 7E L-25

Oct. 22, 1971

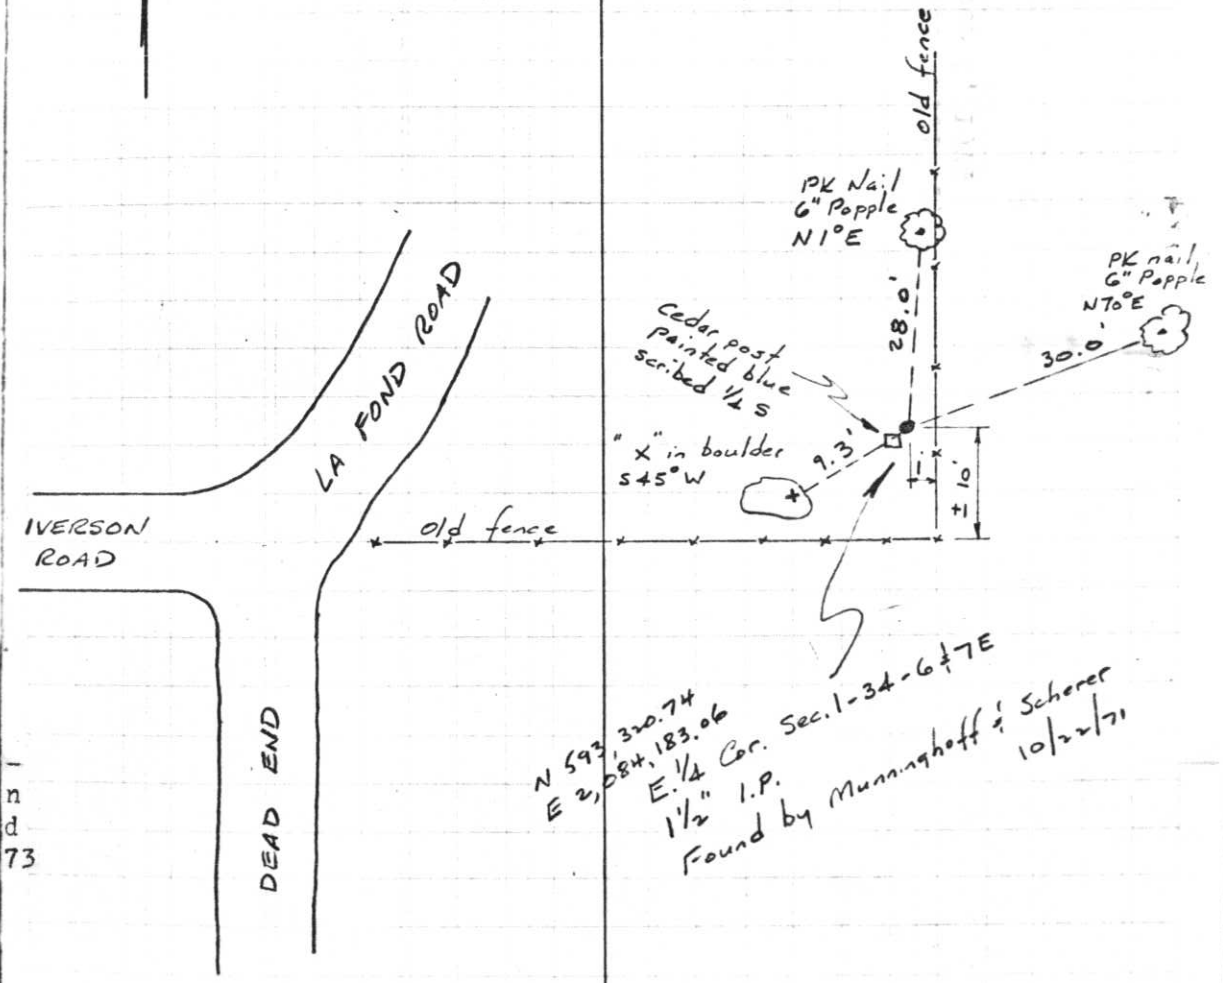

N 593 320.74
E 2,584 183.06
E. 1/4 Cor. Sec. 1-34-6 1/2 7E
1/2" I.P.
Found by Munninghoff & Scherer
10/22/71