

CERTIFIED LAND CORNER RESTORATION

Index No. E-19

State of Wisconsin }
County of Lincoln } ss.

History of original corner establishment:

Surveyor:
Date: 28 December 1854
Monumentation: Wood Post
Witnesses: Spruce 6; N 57° W; 18 links
Spruce 5; S 4° W; 14 links

I Lester J. Schmit, do hereby certify that on the 23rd day of February, 1977, I found evidence of the North 1/4 corner of Section 11 Township 34, North, Range 6 East, Fourth, Principal Meridian, as described hereon; and that from this evidence I established a new monument and accessories as described hereon to perpetuate the original location of this corner.

Description of corner evidence found:

1 1/2" iron pipe, leaning easterly, with a 4" x 4" concrete monument at N 1° W a distance of 32.49". No other evidence apparent. The iron pipe and concrete monument were set by G. W. Smith in 1925 to mark the North 1/4 corner of Section 11.


Resident witnesses:

.....
.....
.....

Description of monument and accessories I established to perpetuate the original location of this corner.

Berntsen Monument - 30" (Set 2" above surface. Monument in swamp.)

Witnesses: P.K. Nail in 5" Black Spruce; N 66°42'05" E; 37.47'
P.K. Nail in 5" Black Spruce; S 30°40'18" E; 29.98'
P.K. Nail in 8" Black Spruce; N 79°39'03" W; 35.24'

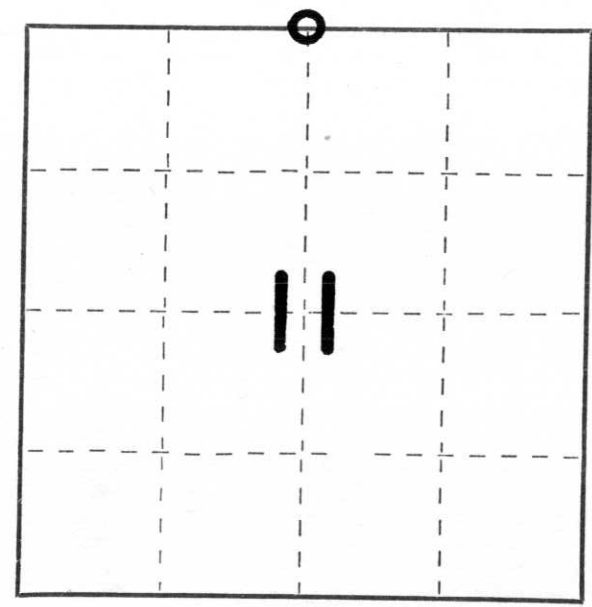

○ = Corner monument restored.

Dated at Tomahawk, Wis., this 4th day of April, 1977.

Signature Lester J. Schmit Title Land Surveyor Registration No. S-1192
(County Surveyor, Registered Land Surveyor, or other duly authorized official)

Office of Register of Deeds, County of _____, I hereby certify that the within instrument was filed in this office for record on the _____ day of _____, 19____ at _____ o'clock _____ M.

.....
(Register of Deeds)

By _____ Deputy