

U.S. PUBLIC LAND SURVEY MONUMENT RECORD

NOTE: THIS FORM IS INTENDED AND DESIGNED TO FULFILL ALL REQUIREMENTS OF WISCONSIN ADMINISTRATIVE CODE, CHAPTER A-E 7.08, U.S. PUBLIC LAND SURVEY MONUMENT RECORD (3)(a)(b)(c)(d)(e)(f)(g)(h)(i). ADDITIONAL SHEETS MAY BE NECESSARY TO CONFORM TO SAID REQUIREMENTS.


T 34 N, R 6 E

(a) CORNER LOCATION:

EAST 1/4 CORNER, SECTION 5
 TOWNSHIP 34 NORTH
 RANGE 6 EAST
 TOWN OF BRADLEY
 LINCOLN COUNTY
 WISCONSIN

(b) HISTORY OF ORIGINAL CORNER:

ORIGINAL SURVEYOR: See Previous Tie Sheet
 COMMENCING DATE:
 COMPLETION DATE:
 ORIGINAL BEARING TREES:

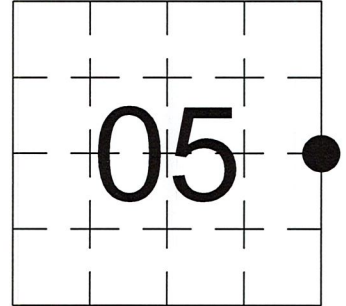


(f)(g)(h) DESCRIPTION OF MONUMENT FOUND AT THIS CORNER AND IF IT WAS ACCEPTED. STATE ALL EVIDENCE (MATERIAL, TESTIMONIAL, OCCUPATIONAL, PLATS, RECORDS, OTHER MONUMENTS) USED AS A BASIS FOR ESTABLISHING LOCATION. IF RE-ESTABLISHING THROUGH LOST CORNER PROPORTIONATE METHODS, INDICATE ALL MONUMENTS, DISTANCES, AND DIRECTIONS USED TO ESTABLISH. INDICATE TYPE OF MONUMENTS FOUND OR SET.

11/27/1974, Edwin Abendroth, set a Berntsen Monument.

11/07/2023, I, Anthony R. Dallman, PLS-2405, found a Berntsen Monument, up 1", under a small pile of asphalt chunks. I accepted this location and set witness monuments, as shown in the sketch below, to further perpetuate the corner location.

(c)(d)(e) PLAN VIEW OF THE CORNER WITH TIES TO AT LEAST FOUR WITNESSES. IF IN DISAGREEMENT WITH PREVIOUSLY ESTABLISHED CORNER, SHOW THE DISTANCES BETWEEN THE TWO CORNERS AND ALSO THE TIES TO THE DISPUTED CORNER.


- Tie bearings by hand-held compass.
- Tie distances by steel tape.
- Not to scale.

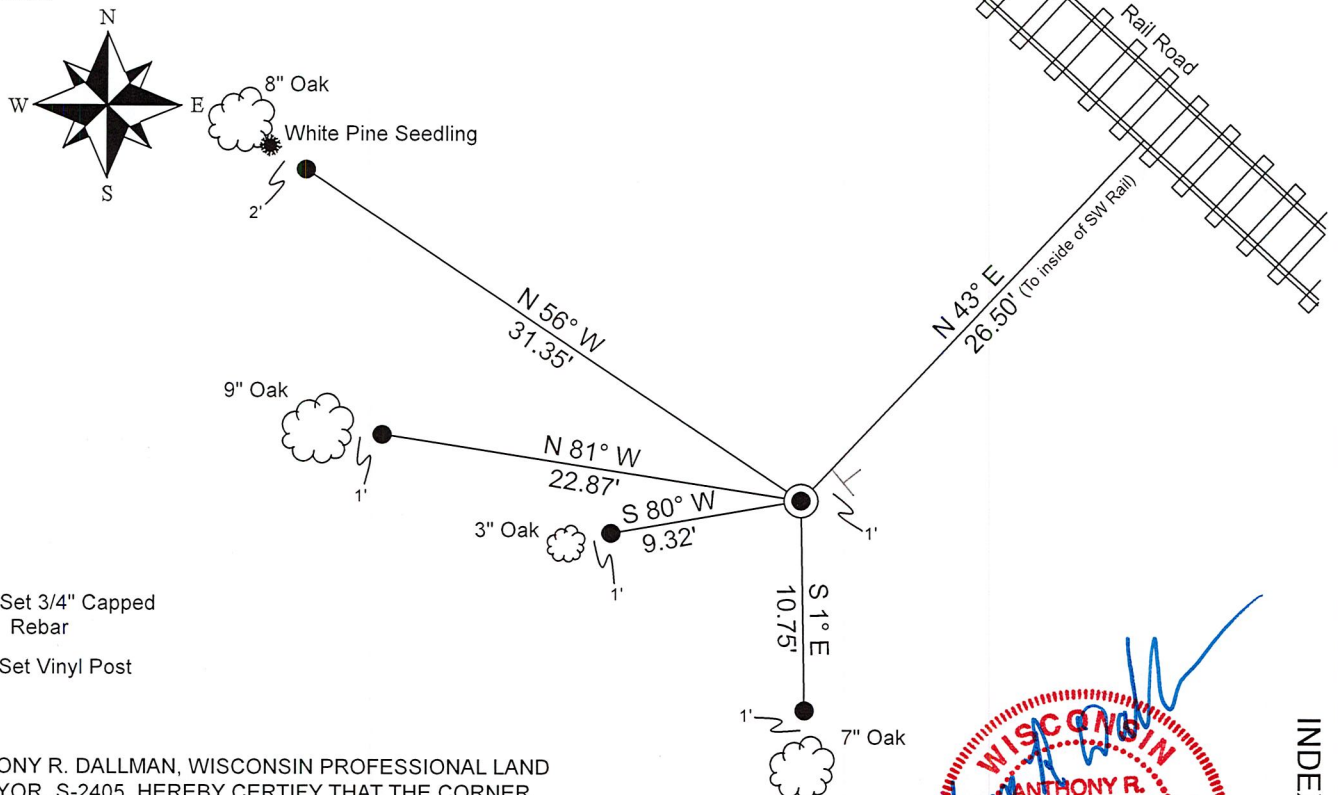

- - Set 3/4" Capped Rebar
- ⊥ - Set Vinyl Post

I, ANTHONY R. DALLMAN, WISCONSIN PROFESSIONAL LAND SURVEYOR, S-2405, HEREBY CERTIFY THAT THE CORNER LOCATION ON THIS RECORD WAS REFERENCED BY ME OR UNDER MY DIRECTION AND CONTROL AND THAT THIS U.S. PUBLIC LAND SURVEY MONUMENT RECORD IS COMPLETE TO THE BEST OF MY KNOWLEDGE AND BELIEF.

Anthony R. Dallman 02/16/24
 ANTHONY R. DALLMAN, PLS S-2405

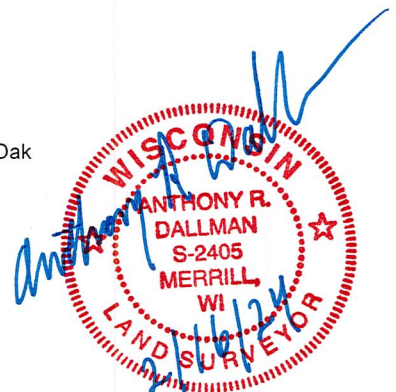

INDEX NO. C-09

43406052000

43406052000_Mon-N



43406052000_North



43406052000_West



43406052000_South



43406052000_East



43406052000
SURKER


CERTIFIED LAND CORNER RESTORATION

Index No. C-9

State of Wisconsin }
 County of Lincoln } ss.

I, _____, do hereby certify that on the 22nd day of November 1974, I found evidence of the East Quarter corner of Section 5 Township 34, North, Range 6 East, Fourth, Principal Meridian, as described hereon; and that from this evidence I established a new monument and accessories as described hereon to perpetuate the original location of this corner.

Resident witnesses:

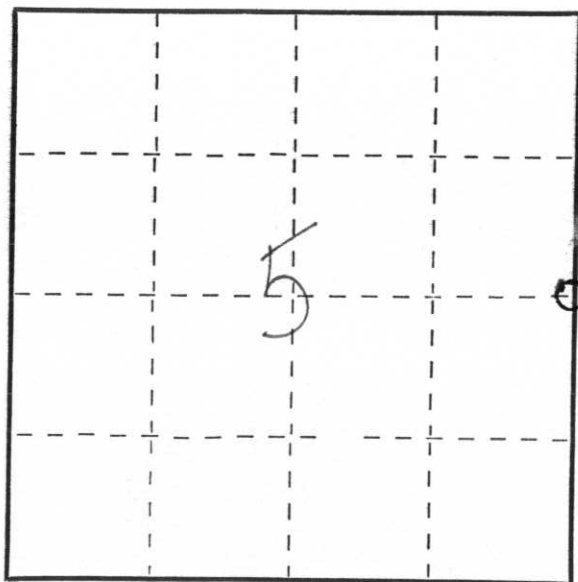

○ = Corner monument restored.


History of original corner establishment:

The original government survey was done in 1855 ±. A corner post was set at 40.00 chains from southeast section corner and witnessed. The bearing trees called for are a 11" tamarac S77°E at 17 links, and a 10" tamarac S22°W at 18 links.

Description of corner evidence found:

Several blazed trees were found in the area. No original bearing trees. Corner location was established by single proportionate measurement. Prorated in accordance with original government notes. Set Bernstein monument and located bearing trees and accessories.

Description of monument and accessories I established to perpetuate the original location of this corner.

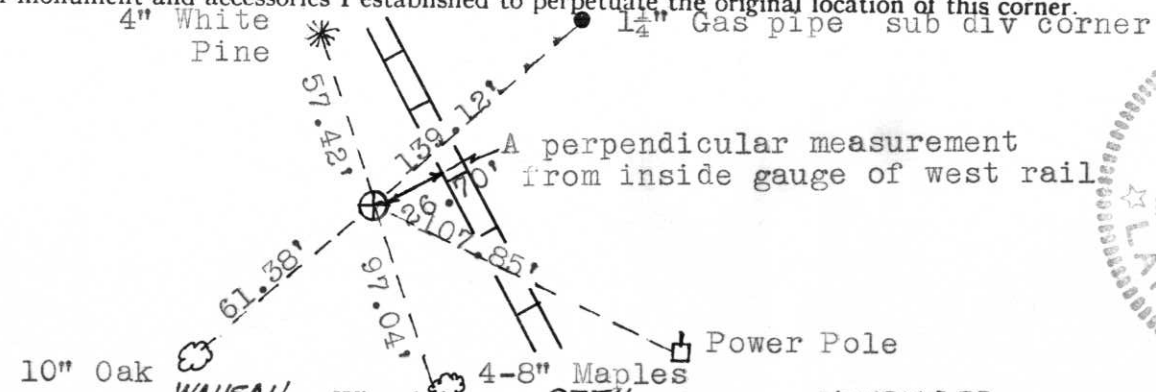

Dated at WAUSAU, Wis., this 27TH day of NOVEMBER, 1974.

Signature Edwin R. Abendroth Title MARATHON CO. SURVEYOR Registration No. 5-798
 (County Surveyor, Registered Land Surveyor, or other duly authorized official)

Office of Register of Deeds, County of _____, I hereby certify that the within instrument was filed in this office for record on the _____ day of _____, 19____ at _____ o'clock _____ M.

 (Register of Deeds)
 By _____ Deputy