

CERTIFIED LAND CORNER RESTORATION


Index No. M-17

State of Wisconsin }
County of Lincoln } ss.

I Lester J. Schmit, do hereby certify that on the 3rd day of April, 1982, I found evidence of the Southeast corner of Section 15 Township 34, North, Range 6 East, Fourth, Principal Meridian, as described hereon; and that from this evidence I established a new monument and accessories as described hereon to perpetuate the original location of this corner.

Resident witnesses:

.....
.....
.....

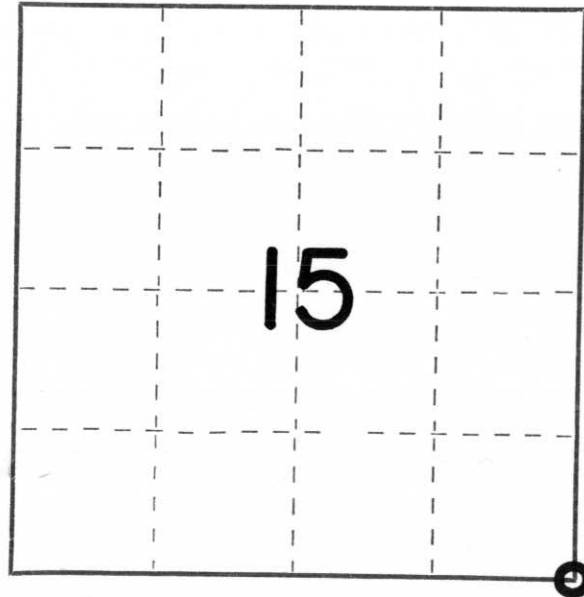

○ = Corner monument restored.

History of original corner establishment:

Surveyor: Jackson L. Prentice
Date: 15 September 1854
Monumentation: Wood Post
Witnesses: Lynn 10", S 44° E, 23 links
Birch 12", S 52° W, 46 links
Birch 11", N 50° W, 39 links
Birch 14", N 84° E, 44 links

Description of corner evidence found: I found an axle shaft in the centreline of Thomas Road for the corner as called for on the Plat of River Oaks Subdivision. The 10" Elm, S 70° E, 64.9' has been cut down because of disease. The P.K. nail in power pole # 3406-14L1, N 7° E, 29.76' is still in place, on the east side of the pole

Description of monument and accessories I established to perpetuate the original location of this corner.

Replaced the axle shaft with a 30" Berntsen monument 4" below road surface.

Witnesses: P.K. nail in power pole # 3406-23W1, S 1° E, 27.74'
1" iron pipe N 45° W, 36.52'
Northwest corner of house foundation, S 46° E, 50.67'

Dated at Tomahawk, Wis., this 7th day of June, 1982.

Signature Lester J. Schmit Title Land Surveyor Registration No. S-1192
(County Surveyor, Registered Land Surveyor, or other duly authorized official)

Office of Register of Deeds, County of....., I hereby certify that the within instrument was filed in this office for record on the..... day of....., 19..... at..... o'clock..... M..

.....
(Register of Deeds)

By..... Deputy