


U.S. PUBLIC LAND SURVEY MONUMENT RECORD

NOTE: This form is intended and designed to fulfill all requirements of Wisconsin Administrative Code, Chapter A-E 5.02, U.S. Public Land Survey Monument Record (3) (a) (b) (c) (d) (e) (f) (g) (h) (i). An additional sheet may be added if necessary to conform with said requirements.

(a) Corner location: Township 34 North
 Range 06 East
 Town/City/Village BRADLEY
 County LINCOLN

(NAD 83 (91))

NORTHING: 208970.244
 EASTING: 386118.638
 LATITUDE: 45°25'03.133"N
 LONGITUDE: 89°42'48.247"W

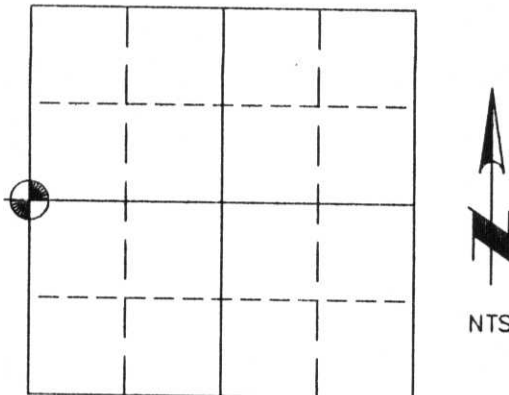

Section 23


(b) (f) (g) (h) Description of monument found at this corner and if it was accepted, state all evidence (material, testimonial, occupational, plats, records, other monuments) used as a basis for accepting. If not accepting or if nothing was found, state evidence as a basis for establishing location. If reestablished through lost corner proportionate methods, indicate all monuments, distances and directions used to establish.

1854 Original surveyor set wood post at this corner with bearing trees as follow:
 Tamarack 10 S74°E 21 links
 Tamarack 12 N65°W 14 links

1998 Kim Pritzlaff, RLS, found a 2" iron pipe perpetuating the corner location, which agreed with local landowner testimony. A monument was set in its place, and ties were set as follow:

(c) (d) (e) Plan view of corner with ties to at least 4 witness monuments. If in disagreement with previously established corner, show the distance between the two corners and also indicate the ties to the disputed corner.

- SET BERNTSEN ALUMINUM MONUMENT WITH CAP STAMPED FOR CORNER
- SET 1"x 30" IRON ROD WITH ALUMINUM CAP
- SET SIGN POST

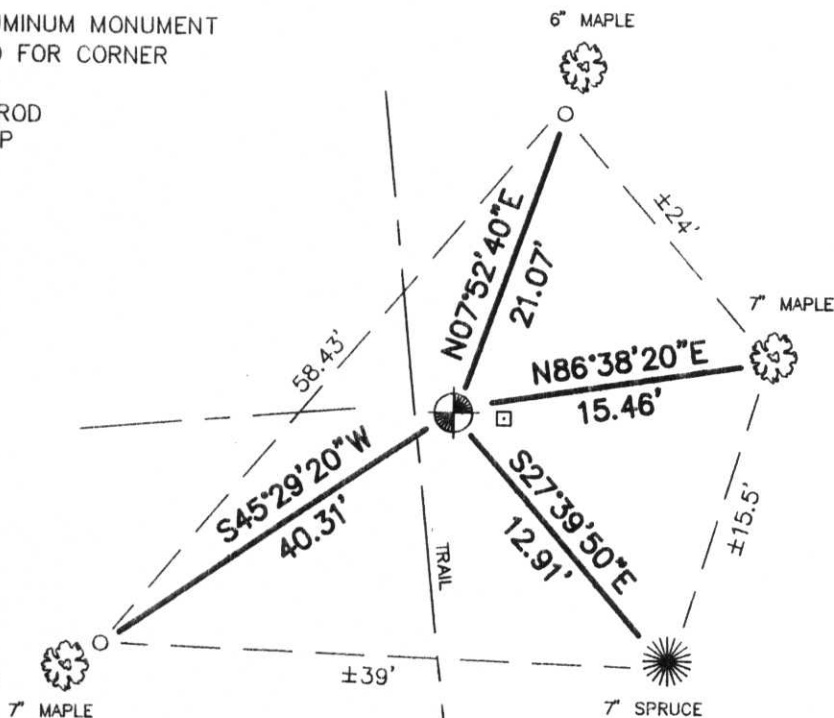

I, Kim H Pritzlaff
 (type or print name) certify that the corner location shown on this record was determined by me or under my direction and control and that this U. S. Public Land Survey Monument Record is correct and complete to the best of my knowledge and belief.

Kim Pritzlaff 11/28/98
 Signature Date

Index No. 0-17

**RECEIVED AT LINCOLN COUNTY
 COURTHOUSE THIS 30th DAY
 OF Nov 19 98**
Pat Priebe
LAND INFORMATION OFFICE