


U.S. PUBLIC LAND SURVEY MONUMENT RECORD ADDENDUM

Note: This form is intended and designed to fulfill all requirements of the Wisconsin Administrative Code, Chapter A-E 7.08 U.S. Public Land Monument Record (3)(a)(b)(c)(d)(e)(f)(g)(h)(i). An additional sheet may be added if necessary to conform with said requirements.

(a) CORNER LOCATION: WISCRS - ** County
 North Quarter corner of Section 26 North:
 Township 34 North East:
 Range 6 East Datum: NAD
 Town of Bradley GNSS Method:
 County of Lincoln GNSS Control:

(RECORDING AREA)

SECTION 26

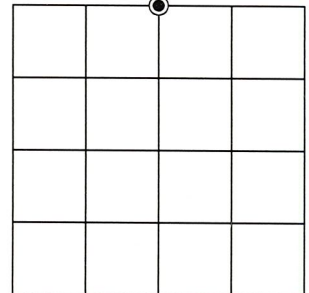

(b) HISTORY OF ORIGINAL CORNER ESTABLISHMENT

Original Surveyor:
 Date of Survey: Commenced
 Completed
 Original B.T.'S


SEE PREVIOUS U.S.P.L.S. MONUMENT RECORD DATED NOVEMBER 25, 1998

(f)(g)(h) DESCRIPTION OF MONUMENT FOUND AT THIS CORNER AND IF IT WAS ACCEPTED, STATE ALL EVIDENCE (MATERIAL, TESTIMONIAL, OCCUPATIONAL, PLATS, RECORD, OTHER MONUMENTS) USED AS A BASIS FOR ESTABLISHING LOCATION. IF NOT ACCEPTED OR IF NOTHING WAS FOUND, STATE EVIDENCE USED AS BASIS FOR ESTABLISHING LOCATION. IF REESTABLISHED THROUGH LOST CORNER PROPORTIONATE METHODS, INDICATE ALL MONUMENTS, DISTANCES AND DIRECTIONS USED TO ESTABLISH. INDICATE TYPE OF MONUMENT AND SIGN POST FOUND OR SET.

This is a perpetuation of a previous U.S.P.L.S. Monument Record by Kim H. Pritzlsff, RLS-1259, dated November 25, 1998, and filed in the office of the Lincoln County Surveyor. A complete history of the corner can be found on the previous monument record. I accept the previous location as a true and faithful perpetuation or reestablishment of the original corner location and further perpetuate it as follows.

April 12, 2023, James D. Rein, PLS No. S-1234, we found and I accepted the 4" dia. capped, Berntsen cast aluminum monument. We further perpetuate it as shown in the plan. The southeasterly double maple and ash are now gone. The northeasterly pine stump is rotted. See below for two additional bearing trees and updated ties to the recovered references.

(c)(d)(e) PLAN VIEW OF CORNER WITH TIES TO AT LEAST 4 WITNESS MONUMENTS. IF IN DISAGREEMENT WITH PREVIOUSLY ESTABLISHED CORNER, SHOW THE DISTANCE BETWEEN THE TWO CORNERS AND ALSO INDICATE THE TIES TO THE DISPUTED CORNER.

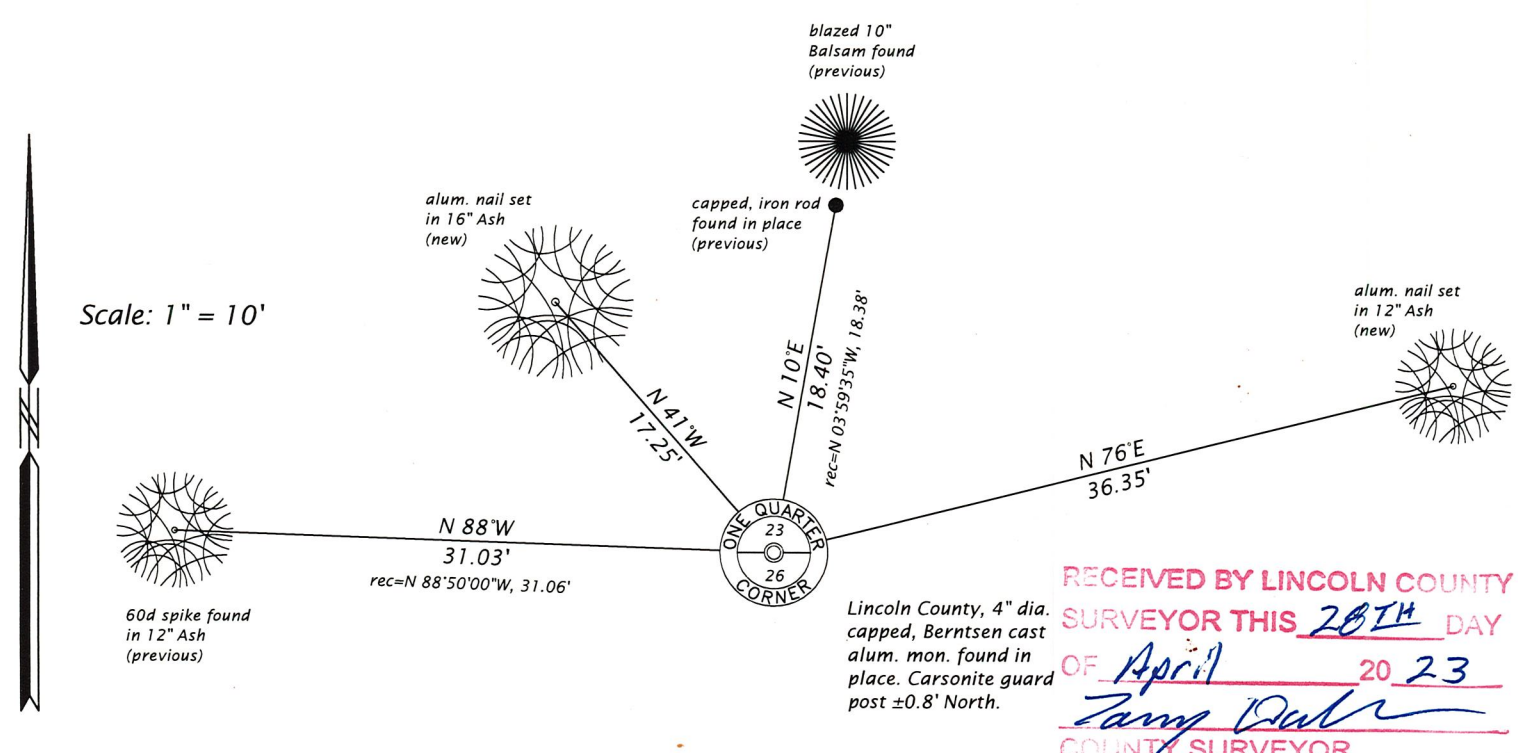

RECEIVED BY LINCOLN COUNTY SURVEYOR THIS 20TH DAY OF April 20 23
James D. Rein
 COUNTY SURVEYOR

(i) I, JAMES D. REIN, PROFESSIONAL LAND SURVEYOR NO. S-1234 HEREBY CERTIFY THAT THE CORNER LOCATION ON THIS RECORD WAS DETERMINED BY ME OR UNDER MY DIRECTION AND CONTROL AND THAT THIS U.S. PUBLIC LAND SURVEY MONUMENT RECORD IS CORRECT AND COMPLETE TO THE BEST OF MY KNOWLEDGE AND BELIEF.

James D. Rein
 SIGNATURE
 4/25/23
 DATE




INDEX NO. Q - 19

43406230020

U.S. PUBLIC LAND SURVEY MONUMENT RECORD

NOTE: This form is intended and designed to fulfill all requirements of Wisconsin Administrative Code, Chapter A-E 5.02, U.S. Public Land Survey Monument Record (3) (a) (b) (c) (d) (e) (f) (g) (h) (i). An additional sheet may be added if necessary to conform with said requirements.

(a) Corner location: Township 34 North
 Range 06 East
 Town/City/Village BRADLEY
 County LINCOLN

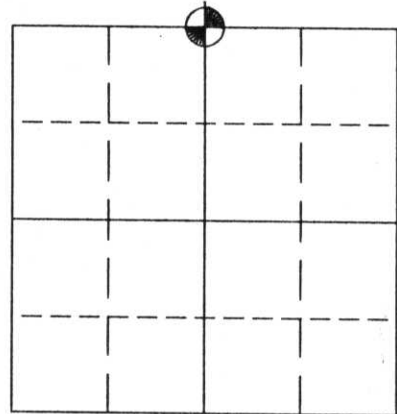

NTS

(NAD 83 (91))

NORTHING: 206284.107
 EASTING: 388571.328

LAT: 45° 24' 36.607" N
 LONG: 89° 42' 13.879" W

Section 26

S-23




(b) (f) (g) (h) Description of monument found at this corner and if it was accepted, state all evidence (material, testimonial, occupational, plats, records, other monuments) used as a basis for accepting. If not accepting or if nothing was found, state evidence as a basis for establishing location. If reestablished through lost corner proportionate methods, indicate all monuments, distances and directions used to establish.


1854 Original surveyor set wood post at this corner with bearing trees as follow:

- Pine 12 N43°E 19 links
- Soft Maple 12 S45°W 21 links

1998 Kim Pritzlaff, RLS, found a 2" iron pipe in place of a 5" squared and scribed wood post which was 14' south of a fence. This location was also marked by an old scribed and rotting Pine stump, and fit the river call to the west by 1/2 chain. A Berntsen monument was set in place with ties as follow:

(c) (d) (e) Plan view of corner with ties to at least 4 witness monuments. If in disagreement with previously established corner, show the distance between the two corners and also indicate the ties to the disputed corner.

-  SET BERNTSEN ALUMINUM MONUMENT WITH CAP STAMPED FOR CORNER
-  SET 1" x 30" IRON ROD WITH ALUMINUM CAP
-  SET SIGN POST

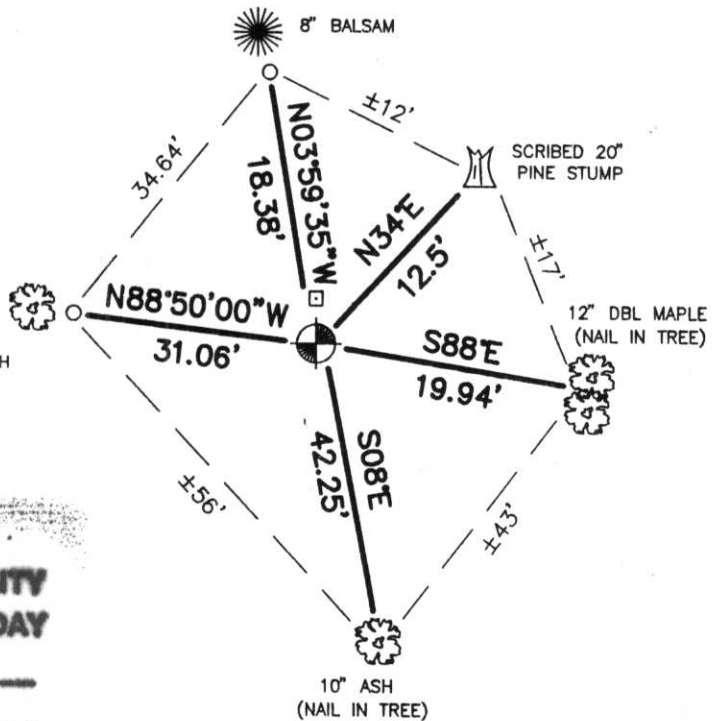

**RECEIVED AT LINCOLN COUNTY
 COURTHOUSE THIS 30th DAY
 OF Nov. 19 98
Pat Priske
 LAND INFORMATION OFFICE**

I, Kim H Pritzlaff
 (type or print name) certify that the corner location shown on this record was determined by me or under my direction and control and that this U. S. Public Land Survey Monument Record is correct and complete to the best of my knowledge and belief.
Kim Pritzlaff 11/25/98
 Signature Date



Index No. A-19