


# U.S. PUBLIC LAND SURVEY MONUMENT RECORD

NOTE: This form is intended and designed to fulfill all requirements of Wisconsin Administrative Code, Chapter A-E 5.02, U.S. Public Land Survey Monument Record (3) (a) (b) (c) (d) (e) (f) (g) (h) (i). An additional sheet may be added if necessary to conform with said requirements.

(a) Corner location: Township 34 North  
 Range 06 East  
 Town/City/Village BRADLEY  
 County LINCOLN

**(NAD 83 (91))**

NORTHING: 203624.276  
 EASTING: 380808.510  
 LAT 45°24'10.361" N  
 LONG 89°44'02.684" W

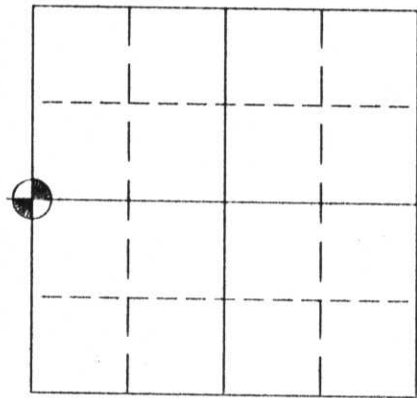

Section 27

(b) (f) (g) (h) Description of monument found at this corner and if it was accepted, state all evidence (material, testimonial, occupational, plats, records, other monuments) used as a basis for accepting. If not accepting or if nothing was found, state evidence as a basis for establishing location. If reestablished through lost corner proportionate methods, indicate all monuments, distances and directions used to establish.



1854 Original surveyor set wood post at this corner with bearing trees as follow:

Tamarack 12 N37°E 14 links  
 Spruce 10 S45°W 16 links

1998 Kim Pritzlaff, RLS, found that all original evidence of corner had been obliterated. Corner was reset at equal distance between section corners and in the centerline of CTH "E", which was the best available evidence. Ties were set as follow:

(c) (d) (e) Plan view of corner with ties to at least 4 witness monuments. If in disagreement with previously established corner, show the distance between the two corners and also indicate the ties to the disputed corner.

- SET BERNTSEN ALUMINUM MONUMENT WITH CAP STAMPED FOR CORNER
- SET 1"x 30" IRON ROD WITH ALUMINUM CAP
- SET SIGN POST

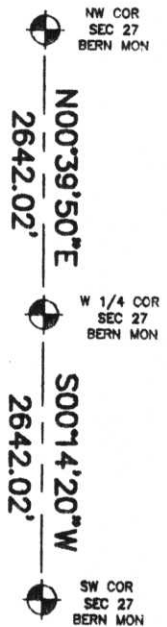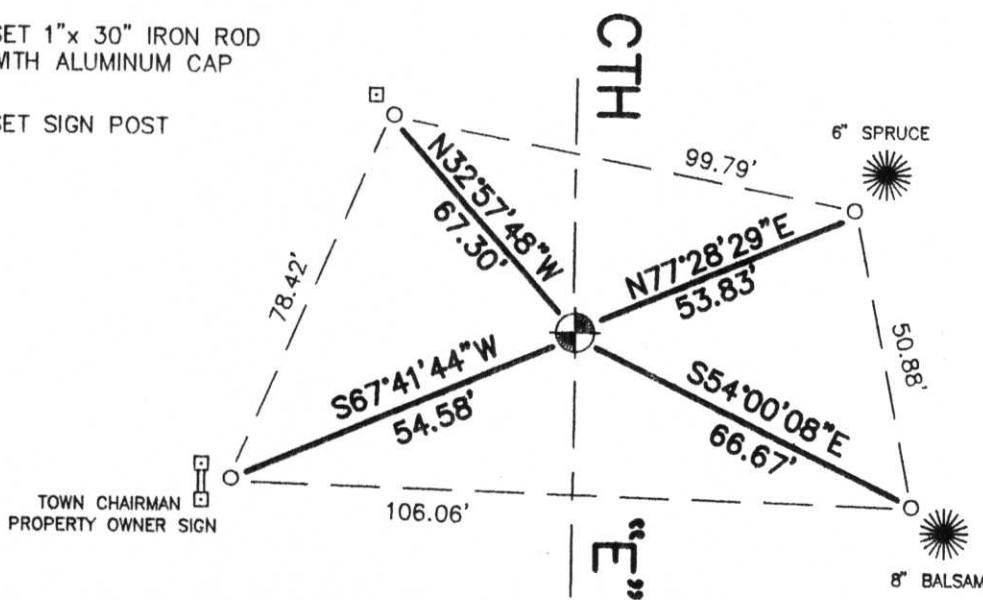

**Kim H Pritzlaff**  
 (type or print name) certify that the corner location shown on this record was determined by me or under my direction and control and that this U. S. Public Land Survey Monument Record is correct and complete to the best of my knowledge and belief.  
 Signature Kim H Pritzlaff Date 11/25/98



Index No. S-13