
## U.S. PUBLIC LAND SURVEY MONUMENT RECORD

Note:	This form is intended and designed to fulfill all requirements of Wisconsin Administrative Cod	e, Chapter	A-E 5.02,	U.S.
	Public Land Survey Monument $(3)(a)(b)(c)(d)(e)(f)(g)(h)(i)$ . An additional sheet may b	e added if	necessary	to
	conform with said requirements.			
(a)	Corner location: Township <u>34</u> North	l i		N

Range\_7\_East SKANAWAN

Town/City/Village\_

County LINCOLN

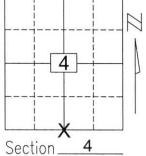


(b)(f)(g)(h) Description of monument found at this corner and if it was accepted, state all evidence (material, testimonial, occupational, plats, records, other monuments)used as a basis for accepting. If not accepted or if nothing was found, state evidence used as basis for establishing location. If reestablished through lost corner proportionate methods, indicate all monuments, distances and directions used to establish.

No evidence of the original corner marker or witness trees were found. I measured several fence lines throughout Section 9 that when considered in whole were a good indication of where the orginal corner location might have been if the fences were built from original monuments. There is a North and South fence runing through the middle of Section 9 that fits well on a straight line and when extended north to the line between Sections 4 and 9, falls within ten feet of the midpoint of a straight line between the corners to Sections 4, 5, 8 & 9, and Sections 3, 4, 9 & 10. I used this North & South fence to set the East & West location of the corner. I found a fence line running between the North & South halves of the Northeast 1/4 of Section 9 that when assumed to be on the 1/4 - 1/4 line fell within twenty feet of the line between section corners as described above. I held this fence to set the North & South location of the corner. Section 4, lying North of Section 9, is heavily wooded and no evidence of fences or other occupation that would be useful in determining the location of this corner was found. I therefore held the fencelines found in Section 9 as the best available evidence of the corner's original location.

(c)(d)(e) Plan view of corner with ties to at least 4 witness monuments. If in disagreement with previously established corner, show the distances between the two corners and also indicate the ties to the disputed corner.

3" CHERRY

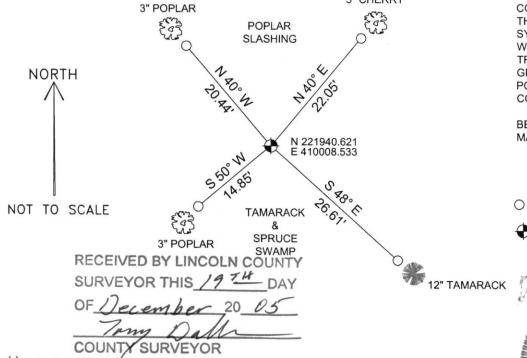

COORDINATES ARE REFERENCED TO THE LINCOLN COUNTY COORDINATE SYSTEM AS DEVELOPED BY THE WISCONSIN DEPARTMENT OF TRANSPORTATION AND ARE BASED ON GPS OBSERVATIONS TO CONTROL POINTS AS SUPPLIED BY LINCOLN

BEARINGS ARE REFERENCED TO MAGNETIC NORTH.

○ - SET 3/4" x 30" REBAR W/ ALUM CAP

SOUTH 1/4 CORNER BERNTSEN MONUMENT SET

I, David A. Řenaud, RLS S—2142, certify that the corner location on this record was determined by me or under my direction and control and that this U.S. Public Land Survey Monument Record is correct and complete to the best of my knowledge and belief.

Signature

