

CERTIFIED LAND CORNER RESTORATION

Index No. C-9

State of Wisconsin }
County of Lincoln } ss.


I, Lester J. Schmit, do hereby certify that on the 26th day of May, 1982, ~~found~~ evidence of the I set the East $\frac{1}{4}$ corner of Section 5 Township 34, North, Range 7 East, Fourth, Principal Meridian, as described hereon; and that from this evidence I established a new monument and accessories as described hereon to perpetuate the original location of this corner.

Resident witnesses:

History of original corner establishment:

Surveyor: Jackson L. Prentice
Date: December 1854
Monumentation: Wood Post
Witnesses: Hemlock 10", N 83° E, 32 links
Birch 12", N 71° W, 33 links


Description of corner evidence found: Found no evidence of the corner location so I single proportioned the location between the Southeast corner and the Northeast corner of Section 5 using the original notes, as shown below.

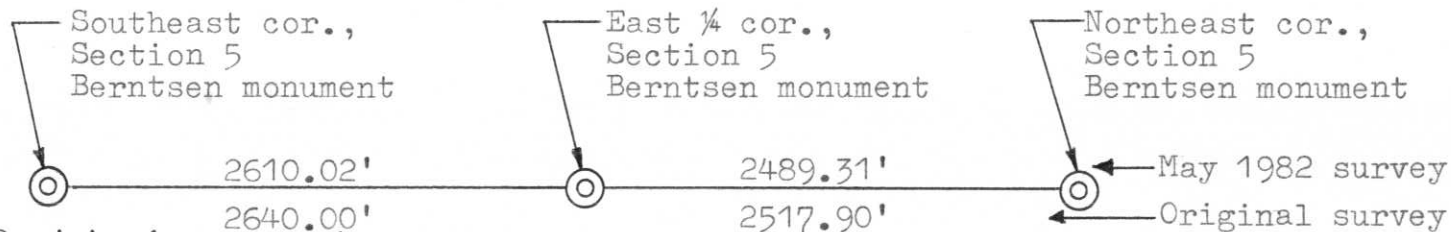

Description of monument and accessories I established to perpetuate the original location of this corner.

Set 30" Berntsen monument for corner 5" below surface and 2.5' west of the centreline of Tower Road.

Witnesses: P.K. nail in 8" Red Maple, N 51° E, 48.39"
P.K. nail in 6" White Pine, N 85° E, 50.38"
P.K. nail in 7" Red Maple, S 54° W, 34.38"
P.K. nail in 7" Red Maple, S 81° W, 42.84"

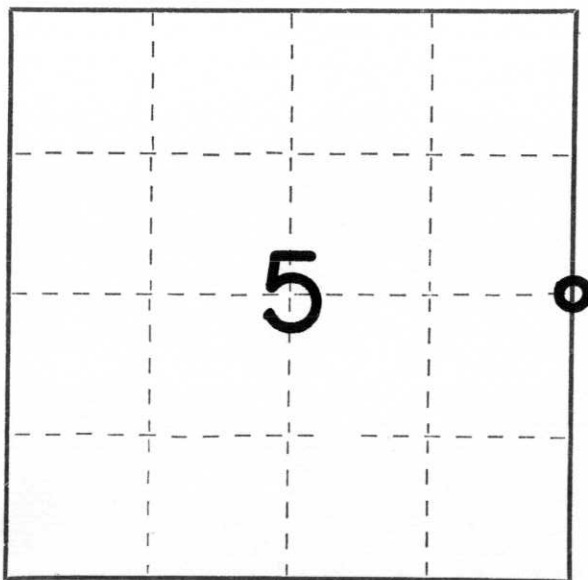

○ = Corner monument restored.

Dated at Tomahawk, Wis., this 7th day of June, 1982.

Signature Lester J. Schmit Title Land Surveyor Registration No. S-1192
(County Surveyor, Registered Land Surveyor, or other duly authorized official)

Office of Register of Deeds, County of _____, I hereby certify that the within instrument was filed in this office for record on the _____ day of _____, 19____ at _____ o'clock _____ M.

(Register of Deeds)

By _____ Deputy