

CERTIFIED LAND CORNER RESTORATION


Index No. I-9

State of Wisconsin }
 County of LINCOLN } ss.

I WILLIAM F. KELLY, do hereby certify that on the 6th day of NOVEMBER, 19 75, I found evidence of the SECTION corner of SECTIONS 8, 9, 17, 16 Township 34, North, Range 7 E, Fourth, Principal Meridian, as described hereon; and that from this evidence I established a new monument and accessories as described hereon to perpetuate the original location of this corner.


Resident witnesses:

.....

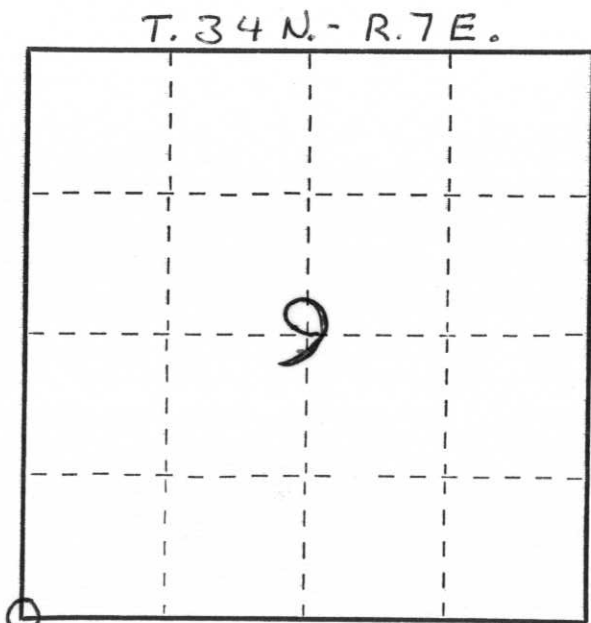

○ = Corner monument restored.


History of original corner establishment:

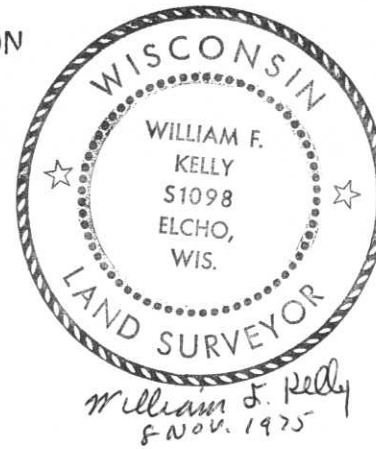

Description of corner evidence found:

Located scribed concrete monument with half of concrete broken off and the monument was split down the middle.

Description of monument and accessories I established to perpetuate the original location of this corner.

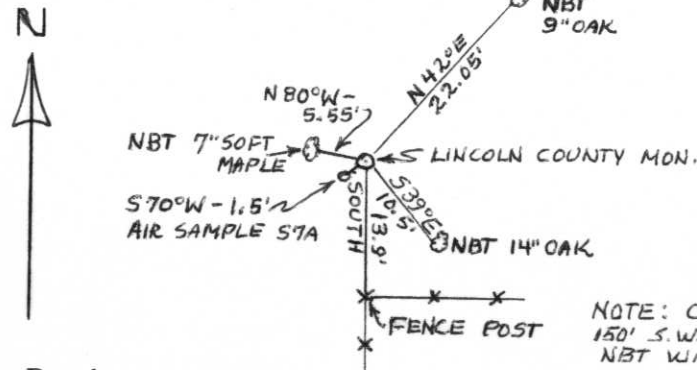

Replaced old monument with new aluminum monument. Scibed new bearing trees and placed a 3" Dia. Oak post next to monument as a guard.



Monument scibed:

Dated at ELCHO, Wis., this 6th day of NOVEMBER, 19 75.

Signature William F. Kelly Title REGISTERED LAND SURVEYOR Registration No. S 1098
 (County Surveyor, Registered Land Surveyor, or other duly authorized official)

Office of Register of Deeds, County of _____, I hereby certify that the within instrument was filed in this office for record on the _____ day of _____, 19 _____ at _____ o'clock _____ M.

(Register of Deeds)

By _____ Deputy