U.S. PUBLIC LAND SURVEY MONUMENT RECORD


This form is intended and designed to fulfill all requirements of Wisconsin Administrative Code, Chapter A-E 5.02, U.S. Public Land Survey Monument Record (3) (a) (b) (c) (d) (e) (f) (g) (h) (I). An additional sheet may be added if necessary to conform with said requirements.



Range _____ Z___ East

Skanawan Town/City/Village __

County Lincoln

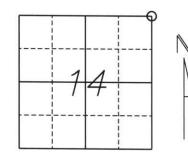

Section

(b) (f) (g) (h) Description of monument found at this corner and if it was accepted, state all evidence (material, testimonial, occupational, plats, records, other monuments) used as a basis for accepting. If not accepted or if nothing was found, state evidence used as a basis for establishing location. If reestablished through lost corner proportionate methods, indicate all monuments, distances and directions used to establish.


Original survey done by Jass L. Nowlin in 1865. Set cedar post with ag trees:

10" Birch S44*W 20 links
11" Aspen S46°E 27 links
10" Aspen N26°E 62 links bearing trees:

11" Aspen

Found a 6"x 6" granite stone set by unknown next to wooden post and a 22" maple to the NW with a Lincoln County plaque. Set (4) rebar with 22" maple to the NW with a Lincoln County plaque. Set (4) rebar with Lincoln County caps as witness monuments approx. 2 feet from bearing trees.

(c) (d) (e) Plan view of corner with ties to at least 4 witness monuments. If in disagreement with previously established corner, show the distances between the two corners and also indicate

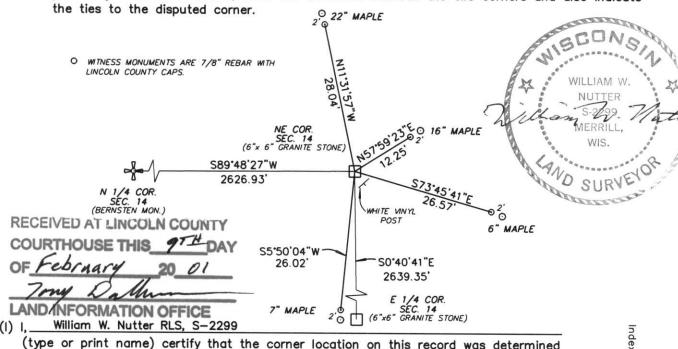

(type or print name) certify that the corner location on this record was determined by me or under my direction and control and that this U.S. Public Land Survey

Monument Record is correct and complete to the best of my knowledge and belief.

Signature

Date

2-9-01