U.S.	<b>PUBLIC</b>	LAND	SURVEY	MONUMENT	RECORD
------	---------------	------	--------	----------	--------


Note: This form is intended and designed to fulfill all requirements of Wisconsin Administrative Code, Chapter A-E 5.02, U.S. Public Land Survey Monument Record (3) (a) (b) (c) (d) (e) (l) (g) (h) (i). An additional sheet may be added if necessary to conform with said requirements.

(a) Corner location: Township 34 North

Range\_\_\_\_\_\_ East

Town Skanawan


County Lincoln

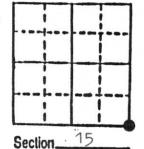

b) (!) (g) (h) Description of monument found at this corner and if it was accepted, state all evidence (material, testimonial, occupational, plats, records, other monuments) used as a basis for accepting. If not accepted or if nothing was found, state evidence used as basis for establishing location. If reestablished through lost corner proportionate methods, indicate all monuments, distances and directions used to establish. Original Gov't. Survey: Dec. 1854 by Jackson Prentice, set wood post for corner with bearings, popple 16 N 59° E 12 links, popple 17 S 63° E 20 links, popple 13, S 27° W 25 links & maple 10 N 17° W 52 links. I found no monument for the corner location. Established the corner location by using a southerly extension of a very old fence line to the north (open cultivated field to the east of very old fence line) and the centreline of Stevenson Road.

c) (d) (e) Plan view of corner with ties to at least 4 witness monuments. If in disagreement with previously established corner, show the distances between the two corners and also indicate the ties to the disputed corner.

R 5"TAMARCK

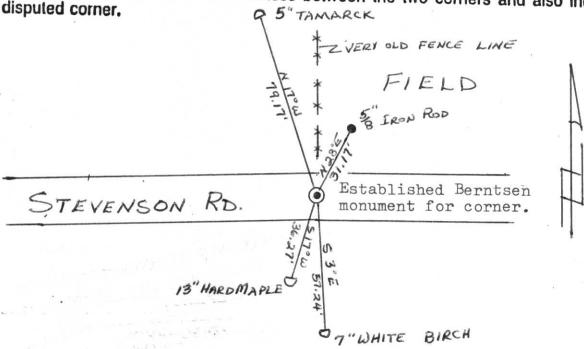

() . Lester J. Schmit

(type or print name) certify that the corner location on this record was determined by me or under my direction and control and that this U.S. Public Land Survey Monument Record is correct and complete to the best of my knowledge and belief.

Susta 9.8chmid

14 Oct 85

Date

