U.S. PUBLIC LAND SURVEY MONUMENT RECORD

This form is intended and designed to fulfill all requirements of Wisconsin Administrative Code, Chapter A-E 5.02, U.S. Public Land Survey Monument Record (3)(a)(b)(c)(d)(e)(f)(g)(h)(i). An additional sheet may be added if necessary to conform with said requirements. Township 34 North (a) Corner location:


Range 7 East

Town/City/Village_

Signature

County LINCOLN


SKANAWAN

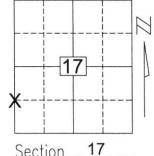

(b)(f)(g)(h) Description of monument found at this corner and if it was accepted, state all evidence (material, testimonial, occupational, plats, records, other monuments)used as a basis for accepting. If not accepted or if nothing was found, state evidence used as basis for establishing location. If reestablished through lost corner proportionate methods, indicate all monuments, distances and directions used to establish.

> This corner falls in a dammed lake and there were no original monuments set. I found an iron pipe as shown on Genisot survey for Martin P. Heise, Oct. 1975. I found no other usable evidence of the original location of the line between Sections 17 & 18. I accepted this pipe to be the best available evidence of the line's original location and set the meander corner on a line between this found pipe and the corner between Sections 7, 8, 17 & 18. I set the 1/4 corner between Sections 17 & 18 as part of this survey — see also notes for the Monument Record Sheet for that corner. I set a Berntsen Lincoln Co. monument at the corner and tied as shown below.

(c)(d)(e) Plan view of corner with ties to at least 4 witness monuments. If in disagreement with previously established corner, show the distances between the two corners and also indicate the ties to the disputed corner.

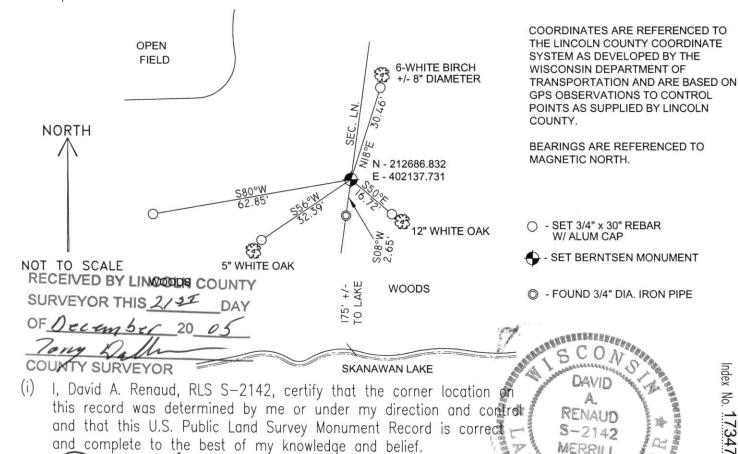

12/21/05

Wil

