

LEONARD L. LAMPERT  
CONSULTING ENGINEER  
220 Greenbriar Ave. - Park Ridge  
Stevens Point, Wisconsin 54481

CERTIFIED LAND CORNER RESTORATION

Index No. Q-5

State of Wisconsin }  
County of..... } ss.

I..... do hereby  
certify that on the.....day  
of....., 19....., I found  
evidence of the.....  
corner of.....  
Township....., North, Range  
....., Fourth, Principal Meridian,  
as described hereon; and that from this evidence  
I established a new monument and accessories  
as described hereon to perpetuate the original  
location of this corner.

Resident witnesses:

.....  
.....  
.....



History of original corner establishment:

Original field notes gave several bearing trees, one of  
which was found with scribing still visible. A wood stake  
was also found at the correct distance and bearing from the  
tree.

Description of corner evidence found:

Found an original bearing tree and the base of a stake at the correct  
distance. Replaced the stake with a Berntsen mon.

Description of monument and accessories I established to perpetuate the original location of this corner:

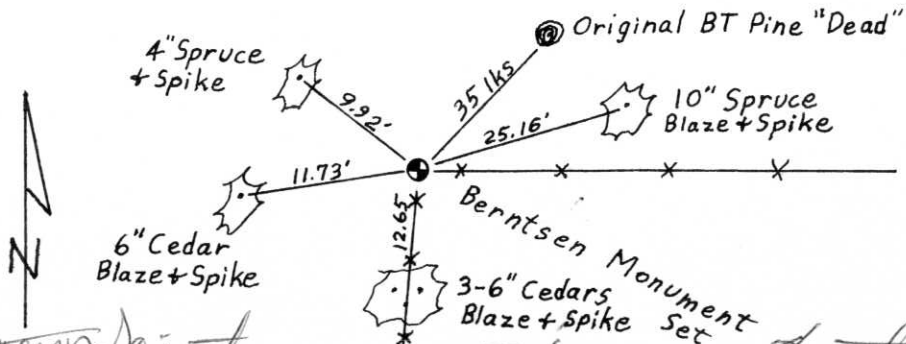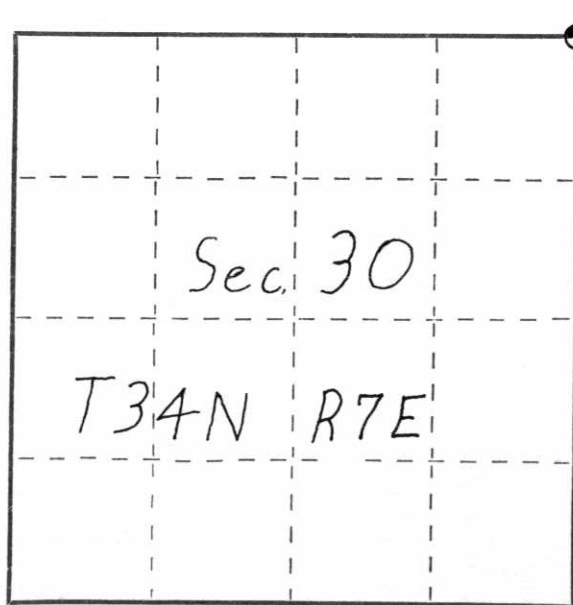

Fb 70, p. 56

Dated at Stevens Point, Wis., this 24 day of September, 19 76  
Signature: Leonard Lampert Title: Consulting Engineer Registration No. S-129  
(County Surveyor, Registered Land Surveyor, or other duly authorized official)

Office of Register of Deeds, County of....., I hereby certify that the within  
instrument was filed in this office for record on the.....day of....., 19.....  
at.....o'clock..... M..

(Register of Deeds)

By.....Deputy

○ = Corner monument restored.