U.S. PUBLIC LAND SURVEY MONUMENT RECORD

This form is intended and designed to fulfill all requirements of Wisconsin Administrative Code, Chapter A-E 5.02, U.S. Public Land Survey Monument Record (3)(a)(b)(c)(d)(e)(f)(g)(h)(i). An additional sheet may be added if necessary to conform with said requirements. Township 34 North (a) Corner location: Range_7_East 26

SKANAWAN Town/City/Village_

and complete to the best of my knowledge and belief.


Signature

County LINCOLN

Section_ (b)(f)(g)(h) Description of monument found at this corner and if it was accepted, state all evidence (material, testimonial, occupational, plats, records, other monuments)used as a basis for accepting. If not accepted or if nothing was found, state evidence used as basis for establishing location. If reestablished through lost corner proportionate methods, indicate all monuments, distances and directions used to establish.

> I found no evidence of the corner's original location or witness trees. I measured the centerline of Stevens Road, adjacent section corners, and found iron pipes at 1/16th corner's next to the corner. I accepted as the best available evidence of the corner's location a spot that would best fit the eividence described above. I set a Lincoln Co. Berntsen monument and tied the corner as shown below.

(c)(d)(e) Plan view of corner with ties to at least 4 witness monuments. If in disagreement with previously established corner, show the distances between the two corners and also indicate the ties to the disputed corner.

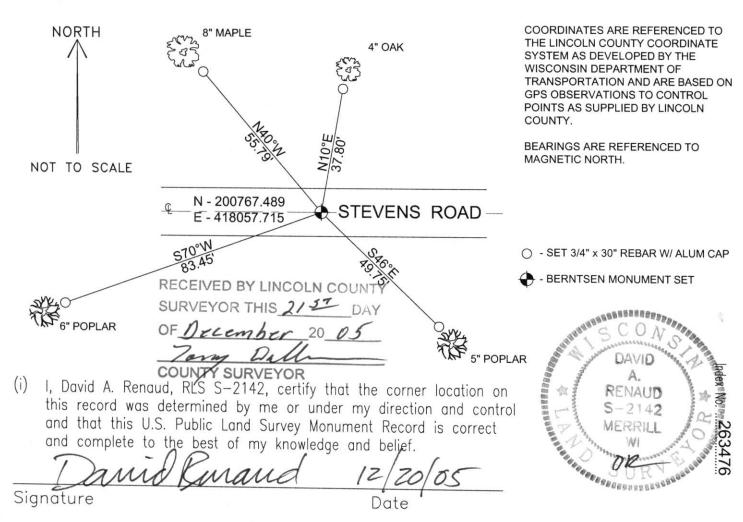

26