


CERTIFIED LAND CORNER RESTORATION

Index No. 0-11

State of Wisconsin }
County of Lincoln } ss.

I Lester J. Schmit, do hereby certify that on the 9th day of July 1984, I found evidence of the North 1/4 corner of Section 33 Township 34, North, Range 7 East, Fourth, Principal Meridian, as described hereon; and that from this evidence I established a new monument and accessories as described hereon to perpetuate the original location of this corner.

Resident witnesses:

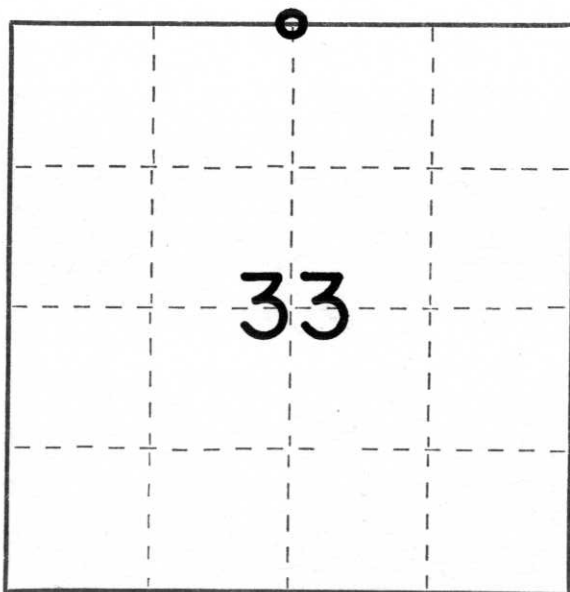

○ = Corner monument restored.

History of original corner establishment:

Surveyor:: Jackson L. Prentice
Date: December 1854
Monumentation: Wood Post
Witnesses: 11" pine, S 15° W, 14 links
12" pine, N 32° W, 19 links

Description of corner evidence found: Found a 2" iron pipe, 5" below surface of blacktop, on the centreline of County Trunk Highway "H" for corner. Referenced by a concrete monument (6" x 6") directly west of corner. Fence line runs southerly of the corner from approximate road right-of-way line. Corner is 4' east of a southerly extension of the centreline of Roth Road from the north.

Description of monument and accessories I established to perpetuate the original location of this corner.
30" Berntsen monument set 1/2" below the surface of the blacktop, for corner.
Witnesses: P.K. nail in power pole # 3407-28R9, N 15° E, 57.90'
5/8" rebar, S 33° E, 24.79'
5/8" rebar, S 18° W, 26.97'
P.K. nail in power pole # 3407-28L10, N 57° W, 45.45'

Dated at Tomahawk, Wis., this 11th day of August, 1984

Signature Lester J. Schmit Title Land Surveyor Registration No. S-1192
(County Surveyor, Registered Land Surveyor, or other duly authorized official)

Office of Register of Deeds, County of _____, I hereby certify that the within instrument was filed in this office for record on the _____ day of _____, 19____ at _____ o'clock _____ M.

(Register of Deeds)

By _____ Deputy