


160.


FIELD SURVEY NOTES
PRESERVATION OF LANDMARKS
 (Pursuant to Section 59.635(7) Wisconsin Statutes)

Wisconsin Department of Transportation
 E-D-707-67

COUNTY <i>Lincoln</i>		
TOWN <i>SKAHAWAN</i>		
HIGHWAY <i>U.S.H. 51 FREEWAY</i>		
SECTION <i>30</i>	TOWNSHIP <i>T34N</i>	RANGE <i>R7E</i>
TYPE OF LANDMARK <i>South 1/4 corner</i>		

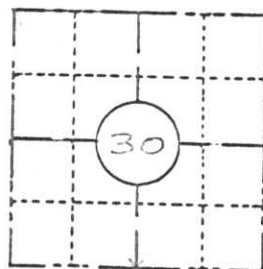

LOCATION SKETCH
 (Location of landmark indicated by "x")

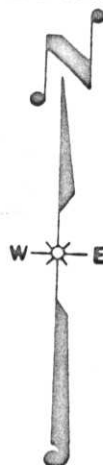

This space for copy of field notes or ties to the above described landmarks


No evidence of the original corner or accessories or any retracement work was found, even after a careful & extensive ground and aerial photo search was made.

Therefore; the position was proportioned against the original distances after establishing the Section Corners.

Set Berntsen Aluminum monument and made Bearing Trees.

$\frac{25}{30} \mid \frac{30}{36131}$

relocated from
 1921 SHCW Survey

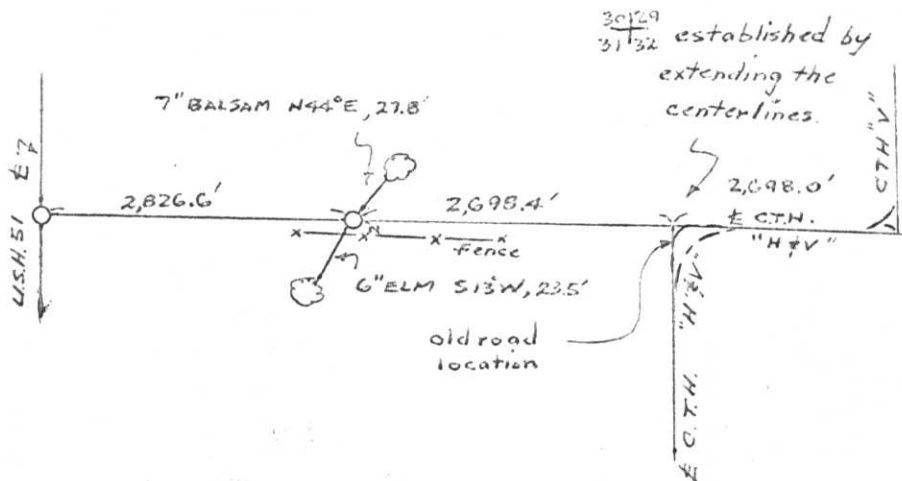

FILED UNDER PROJECT U.S.H. 51 FREEWAY		
NUMBER I.D. 1173-0-02		
SHC DISTRICT OFFICE NUMBER <i>7</i>	CITY	COUNTY <i>Lincoln</i>
LOCATED OR ESTABLISHED BY <i>Northwoods Surveyors, Inc.</i>		
NAME <i>Robert H. Wiscel</i>		
TITLE <i>Land Surveyor S-1090</i> DATE <i>Dec. 1972</i>		

COUNTY CLERK'S OFFICE	
COUNTY OF <i>Lincoln</i>	WISCONSIN } SS
DATE RECEIVED FOR RECORD <i>1/24/73</i>	DATE COPY SENT TO COUNTY SURVEYOR <i>✓</i>
SIGNATURE OF COUNTY CLERK <i>Ken Oldenberg</i>	

U-3


FIELD SURVEY NOTES

PRESERVATION OF LANDMARKS

(Pursuant to Section 59.635(7) Wisconsin Statutes)

Wisconsin Department of Transportation
E-D-707-67

COUNTY <i>Lincoln</i>		
TOWN <i>SKAHAWAN</i>		
HIGHWAY <i>U.S.H. 51 FREEWAY</i>		
SECTION <i>30</i>	TOWNSHIP <i>T34N</i>	RANGE <i>R7E</i>
TYPE OF LANDMARK <i>South 1/4 corner</i>		

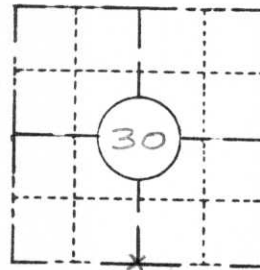

LOCATION SKETCH
(Location of landmark indicated by "x")



This space for copy of field notes or ties to the above described landmarks


No evidence of the original corner or accessories or any retracement work was found, even after a careful & extensive ground and aerial photo search was made.

Therefore; the position was proportioned against the original distances after establishing the Section Corners.

Set Berntsen Aluminum monument and made Bearing Trees.

$\frac{25}{30} \mid \frac{30}{31}$

relocated from
1921 SHCW Survey

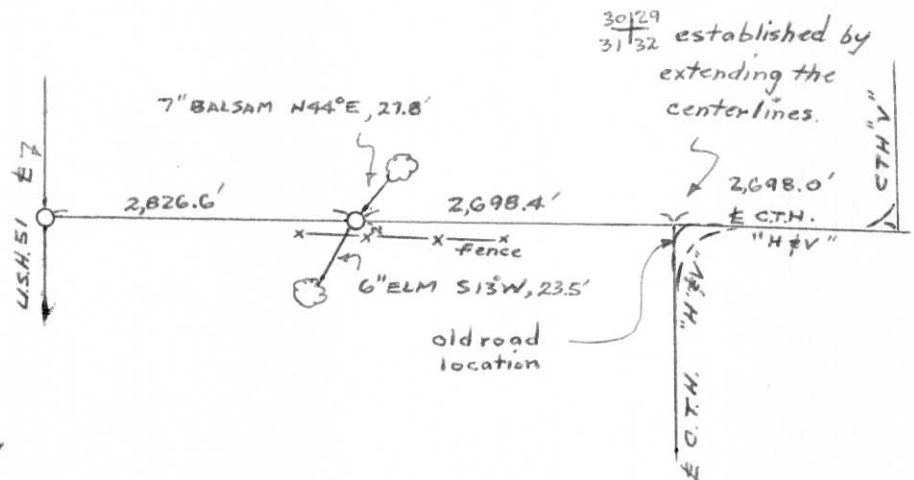

$\frac{30}{29} \mid \frac{31}{32}$ established by extending the centerlines.

FILED UNDER PROJECT <i>U.S.H. 51 FREEWAY</i>	
NUMBER I.D. <i>1173-0-02</i>	
SHC DISTRICT OFFICE NUMBER <i>7</i>	CITY <i>Lincoln</i>
COUNTY <i>Lincoln</i>	
LOCATED OR ESTABLISHED BY <i>Northwoods Surveyors, Inc.</i>	
NAME <i>Robert H. Winal</i>	
TITLE <i>Land Surveyor S-1090</i>	DATE <i>Dec. 1972</i>

COUNTY CLERK'S OFFICE	
COUNTY OF <i>Lincoln</i>	WISCONSIN } SS
DATE RECEIVED FOR RECORD <i>1/24/73</i>	DATE COPY SENT TO COUNTY SURVEYOR <i>[check]</i>
SIGNATURE OF COUNTY CLERK <i>Ken Oldenburg</i>	