

CERTIFIED LAND CORNER RESTORATION


Index No. W-13

State of Wisconsin }
County of Lincoln } ss.

I Lester J. Schmit, do hereby
certify that on the 10th day
of May, 1979, I found
evidence of the East 1/4
corner of Section 33
Township 34, North, Range
7 East, Fourth, Principal Meridian,
as described hereon; and that from this evidence
I established a new monument and accessories
as described hereon to perpetuate the original
location of this corner.

Resident witnesses:

.....
.....
.....

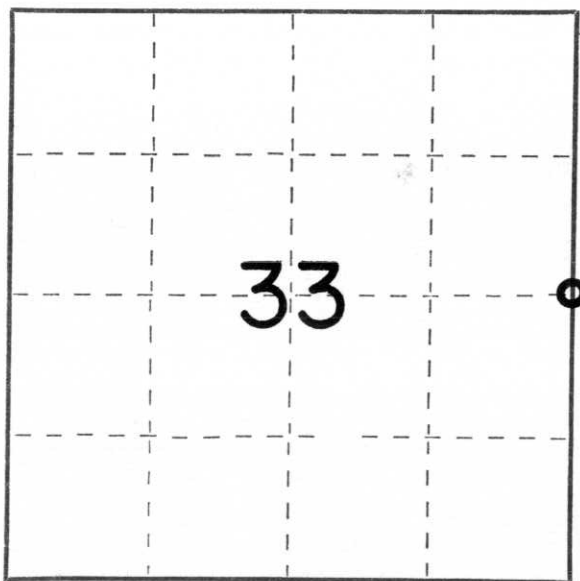

○ = Corner monument restored.

History of original corner establishment:

Surveyor: Jackson L. Prentice
Date: December 1854
Monumentation: Wood Post
Witnesses: 10" Birch, N 66° E, 28 lks.
11" Birch, S 68° W, 26 lks.

Description of corner evidence found:

1 1/2" iron pipe with a squared wood post next to it. A 5" White Birch bears S 48° E, 21.09' & a 6" Sugar Maple bears N 73° W, 10.87'.

Description of monument and accessories I established to perpetuate the original location of this corner.

Berntsen Monument - 30" (Flush with surface of ground)

P.K. Nail in 7" White Birch, N 78° E, 9.82'
P.K. Nail in 6" Ironwood, S 9° W, 28.08'

Dated at Tomahawk, Wis., this 8th day of June, 1979

Signature Lester J. Schmit Title Land Surveyor Registration No. S-1192
(County Surveyor, Registered Land Surveyor, or other duly authorized official)

Office of Register of Deeds, County of _____, I hereby certify that the within
instrument was filed in this office for record on the _____ day of _____, 19____
at _____ o'clock _____ M.

.....
(Register of Deeds)

By _____ Deputy