## U.S. PUBLIC LAND SURVEY MONUMENT RECORD


This form is intended and designed to fulfill all requirements of Wisconsin Administrative Code, Chapter A-E 5.02, U.S. Public Land Survey Monument  $\widetilde{Record}$  (3)(a)(b)(c)(d)(e)(f)(g)(h)(i). An additional sheet may be added if necessary to conform with said requirements.

Township 34 North (a) Corner location:

Range 7 East

Town/City/Village\_ **SKANAWAN** 

County LINCOLN

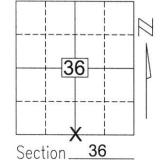


(b)(f)(q)(h) Description of monument found at this corner and if it was accepted, state all evidence (material, testimonial, occupational, plats, records, other monuments)used as a basis for accepting. If not accepted or if nothing was found, state evidence used as basis for establishing location. If reestablished through lost corner proportionate methods, indicate all monuments, distances and directions used to establish.

> I found no evidence of the corner's original marker or witness trees. I found a scribed 6-in. x 6-in. stone at the corner that is shown on filed surveys as being at the corner, and is similar to those set by Fuchs in the 1930's to perpetuate the original corner markers in this Township. I accepted the stone as the best available evidence of the corner's original location and tied as shown below.

RECEIVED BY LINCOLN COUNTY SURVEYOR THIS 2/37 DAY

OF <u>Occember</u> 20 05 Zony Dall COUNTY SURVEYOR

(c)(d)(e) Plan view of corner with ties to at least 4 witness monuments. If in disagreement with previously established corner, show the distances between the two corners and also indicate the ties to the disputed corner.

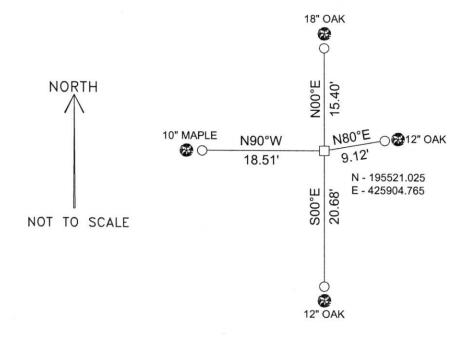

COORDINATES ARE REFERENCED TO THE LINCOLN COUNTY COORDINATE SYSTEM AS DEVELOPED BY THE WISCONSIN DEPARTMENT OF TRANSPORTATION AND ARE BASED ON GPS OBSERVATIONS TO CONTROL POINTS AS SUPPLIED BY LINCOLN COUNTY.

BEARINGS ARE REFERENCED TO MAGNETIC NORTH.

O - SET 3/4" x 30" REBAR W/ ALUM CAP

SOUTH FOUND 6XC FOUND 6X6 GRANITE STONE

MERRILL

I, David A. Renaud, RLS S-2142, certify that the corner location on this record was determined by me or under my direction and control and that this U.S. Public Land Survey Monument Record is correct and complete to the best of my knowledge and belief.

Signature

