

# U.S. PUBLIC LAND SURVEY MONUMENT RECORD


Note: This form is intended and designed to fulfill all requirements of Wisconsin Administrative Code, Chapter A-E 5.02, U.S. Public Land Survey Monument Record (3) (a) (b) (c) (d) (e) (f) (g) (h) (i). An additional sheet may be added if necessary to conform with said requirements.

(a) Corner location: Township 34 North

Range 8 East

Town/City/Village Harrison


County Lincoln

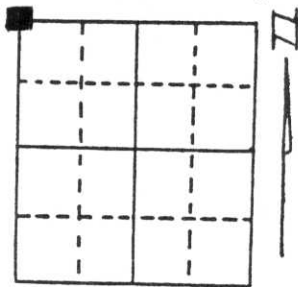

Section 16

(b) (f) (g) (h) Description of monument found at this corner and if it was accepted, state all evidence (material, testimonial, occupational, plats, records, other monuments) used as a basis for accepting. If not accepted or if nothing was found, state evidence used as basis for establishing location. If reestablished through lost corner proportionate methods, indicate all monuments, distances and directions used to establish. Original Gov't. Survey: 1854 by Jackson Prentice, set wood post for corner with bearings, pine 10 S 27° E 29 links, pine 9 S 11° W 36 links, tamarack 10 N 27° W 28 links & tamarack 11 N 26° E 40 links. In a 1937 survey by Francis Fox, he unearthed an old stake preserved in the wet swamp. Set stone in swamp & mounded with sand. 66' east to leave swamp. Corner witnessed by hemlock 10 S 53° E 78.8 links, white pine 14 S 60° W 41.51 links, white pine 5 N 51° W 80.8 links & white pine 13 N 66° E 47.58 links. I found the granite and the 14" white pine (now a rampike) in a very wet swamp which is now being flooded because of beaver, damming up of the small lake to the north. Made new witnesses as shown below.

(c) (d) (e) Plan view of corner with ties to at least 4 witness monuments. If in disagreement with previously established corner, show the distances between the two corners and also indicate the ties to the disputed corner.

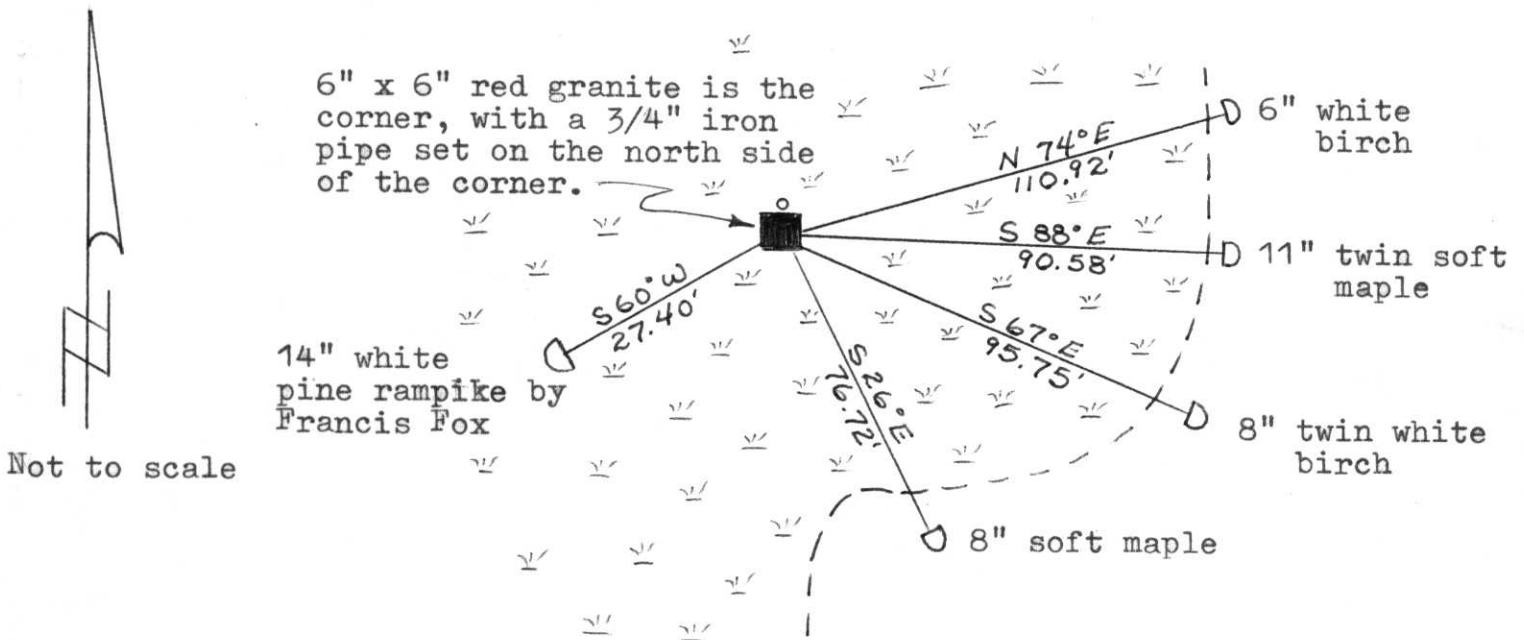

Not to scale

(i) I, Lester J. Schmit R.L.S. 1192  
 (type or print name) certify that the corner location on this record was determined by me or under my direction and control and that this U.S. Public Land Survey Monument Record is correct and complete to the best of my knowledge and belief.

Lester J. Schmit Signature 7 May 92 Date



Index No. I-9