


# U.S. PUBLIC LAND SURVEY MONUMENT RECORD

Note: This form is intended and designed to fulfill all requirements of Wisconsin Administrative Code, Chapter A-E 5.02, U.S. Public Land Survey Monument Record (3) (a) (b) (c) (d) (e) (f) (g) (h) (i). An additional sheet may be added if necessary to conform with said requirements.

(a) Corner location: Township 34 North  
 Range 8 East

Town/City/Village Harrison

County Lincoln

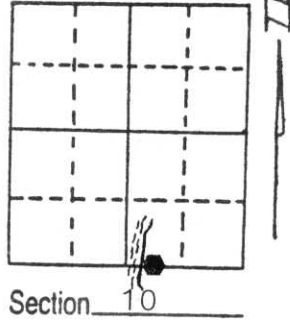

(b) (f) (g) (h) Description of monument found at this corner and if it was accepted, state all evidence (material, testimonial, occupational, plats, records, other monuments) used as a basis for accepting. If not accepted or if nothing was found, state evidence used as basis for establishing location. If reestablished through lost corner proportionate methods, indicate all monuments, distances and directions used to establish.

Original- Government set meander post and made the following  
 BT'S Pine 10" S 67° E 30 lks; Pine 14" N 63° W  
 15 lks.


Fox- Set MC on east shore of Buteau Lake. Found pine stump  
 24", N 45° E 13.2 lks.

Genisot- 1968 found 6x6 granite monument for MC.

Genisot- 1996 found 6x6 granite monument for MC. Witnessed  
 as shown below.

(c) (d) (e) Plan view of corner with ties to at least 4 witness monuments. If in disagreement with previously established corner, show the distances between the two corners and also indicate the ties to the disputed corner.

NOTE: SET ORANGE  
 CARSTENITE POST 15' EAST  
 OF CORNER. CORNER IS 1.50'  
 WEST OF HIGH WATER MARK  
 OF BUTEAU LAKE. NO SCALE.

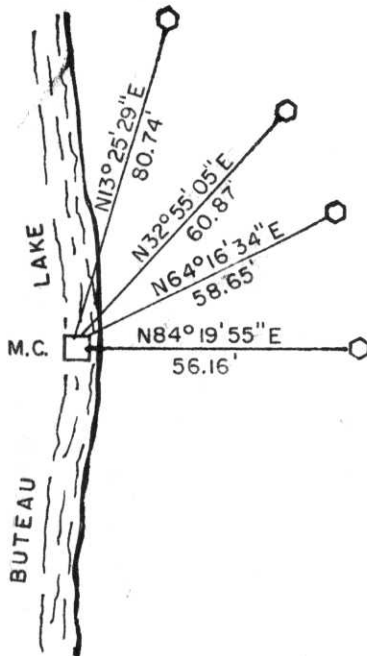

BEARINGS REF. TO THE  
 SOUTH LINE SEC.10, T34N,  
 R8E, ASSUMED TO BEAR  
 S88°19'20\"W.



LEGEND

- SET 3/4" IRON ROD
- FOUND 6" x 6" GRANITE MON.

RECEIVED AT LINCOLN COUNTY  
 COURTHOUSE THIS 16th DAY  
 OF Oct 1996  
 Tax DESCRIPTION OFFICE

(i) I, William E. Bandow  
 (type or print name) certify that the corner location on this record  
 was determined by me or under my direction and control and that  
 this U.S. Public Land Survey Monument Record is correct and  
 complete to the best of my knowledge and belief.

William E. Bandow 10-14-96  
 Signature Date



Index No. F-1516