


# U.S. PUBLIC LAND SURVEY MONUMENT RECORD

NOTE: This form is intended and designed to fulfill all requirements of Wisconsin Administrative Code, Chapter A-E 7.08 U.S. Public Land Survey Monument Record (3)(a)(b)(c)(d)(e)(f)(g)(h)(i). An additional sheet may be added if necessary to conform with said requirements.

(a) Corner location: Township 34 North  
 Range 08 East  
 Town of HARRISON  
 LINCOLN County, Wisconsin

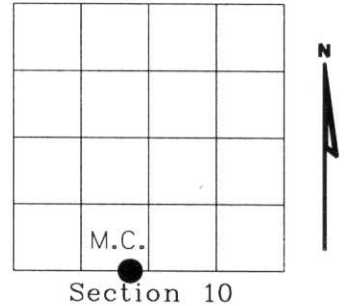

(b)(f)(g)(h) Description of monument found at this corner and if it was accepted, state all evidence (material, testimonial, occupational, plats, records, other monuments) used as a basis for accepting. If not accepted or if nothing was found, state evidence used as basis for establishing location. If reestablished through lost corner proportionate methods, indicate all monuments, distances and directions used to establish. Indicate type of monument found or set and sign post.

- 1854 - Original corner set by Jackson L. Prentice.
- 1938 - Frances Fuchs set wood post, a small bay lies north of line.
- 1969 - William S. Camerson set a 2" diameter iron pipe.  
 BTs found: 6" Maple S67°E 21.4'  
 6" Hemlock N5°W 8.9'
- 2003 - I found 2" diameter iron pipe and 4"x4" sq post scribed M.C.  
 BTs: 11" Hemlock N5°W 8.9'  
 8" Maple S67°E 21.4'

Witnessed as shown below.

RECEIVED AT LINCOLN COUNTY  
 COURTHOUSE THIS 17<sup>TH</sup> DAY  
 OF February 20 03  
*Tony Dallen*  
 LAND INFORMATION OFFICE

(c)(d)(e) Plan view of corner with ties to at least 4 witness monuments. If in disagreement with previously established corner, show the distances between the two corners and also indicate the ties to the disputed corner.

- ◇ FOUND 2" DIA IRON PIPE
- SET 3/4" DIA. IRON ROD WITH CAP STAMPED AS SHOWN
- † WHITE PLASTIC SIGN SET 1' SOUTH



(i) I, Dennis B. Roberts, Registered Land Surveyor \*S-1863, hereby certify that the corner location on this record was determined by me or under my direction and control and that this U.S. Public Land Survey Monument Record is correct and complete to the best of my knowledge and belief.



*Dennis B. Roberts*  
 Signature 01-07-03  
 Date

Index No. I-1415