

U.S. PUBLIC LAND SURVEY MONUMENT RECORD

NOTE: THIS FORM IS INTENDED AND DESIGNED TO FULFILL ALL REQUIREMENTS OF WISCONSIN ADMINISTRATIVE CODE, CHAPTER A-E 7.08, U.S. PUBLIC LAND SURVEY MONUMENT RECORD (3)(a)(b)(c)(d)(e)(f)(g)(h)(i). ADDITIONAL SHEETS MAY BE NECESSARY TO CONFORM TO SAID REQUIREMENTS.


T 34 N, R 8 E

(a) CORNER LOCATION:

EAST QUARTER CORNER, SECTION 10
 TOWNSHIP 34 NORTH
 RANGE 8 EAST
 TOWN OF HARRISON
 LINCOLN COUNTY
 WISCONSIN

(b) HISTORY OF ORIGINAL CORNER:

ORIGINAL SURVEYOR: Jackson L. Prentice, Set post
 COMMENCING DATE: November 27, 1854
 COMPLETION DATE: December 11, 1854
 ORIGINAL BEARING TREES:
 16" Hemlock; S 76° W; 37 links
 11" Birch; N 87° E; 55 links

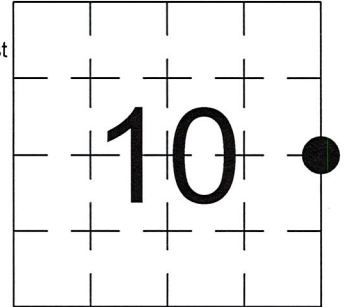

(f)(g)(h) DESCRIPTION OF MONUMENT FOUND AT THIS CORNER AND IF IT WAS ACCEPTED. STATE ALL EVIDENCE (MATERIAL, TESTIMONIAL, OCCUPATIONAL, PLATS, RECORDS, OTHER MONUMENTS) USED AS A BASIS FOR ESTABLISHING LOCATION. IF RE-ESTABLISHING THROUGH LOST CORNER PROPORTIONATE METHODS, INDICATE ALL MONUMENTS, DISTANCES, AND DIRECTIONS USED TO ESTABLISH. INDICATE TYPE OF MONUMENTS FOUND OR SET.

1938, Francis Fox found very old $\frac{1}{4}$ post and set 6" X 6" Granite Monument.


1968, Genisot & Associates found Fox's 6" X 6" Granite Monument and set reference ties.

2002, Dennis Roberts, MSA, found Fox's Granite and set reference ties.


5/13/2019, I, Anthony R. Dallman, PLS-2405, found Fox's Granite and 4 of Roberts' ties, 1 tie was disturbed by an uprooted tree. I accepted this location and set a new reference tie to further perpetuate the corner location as shown in the sketch below.

(c)(d)(e) PLAN VIEW OF THE CORNER WITH TIES TO AT LEAST FOUR WITNESSES. IF IN DISAGREEMENT WITH PREVIOUSLY ESTABLISHED CORNER, SHOW THE DISTANCES BETWEEN THE TWO CORNERS AND ALSO THE TIES TO THE DISPUTED CORNER.

- Tie bearings by hand-held compass.
- Tie distances by steel tape.
- Not to scale.

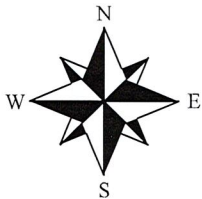

- - Set 7/8" Capped Rebar
- - Found 7/8" Capped Rebar

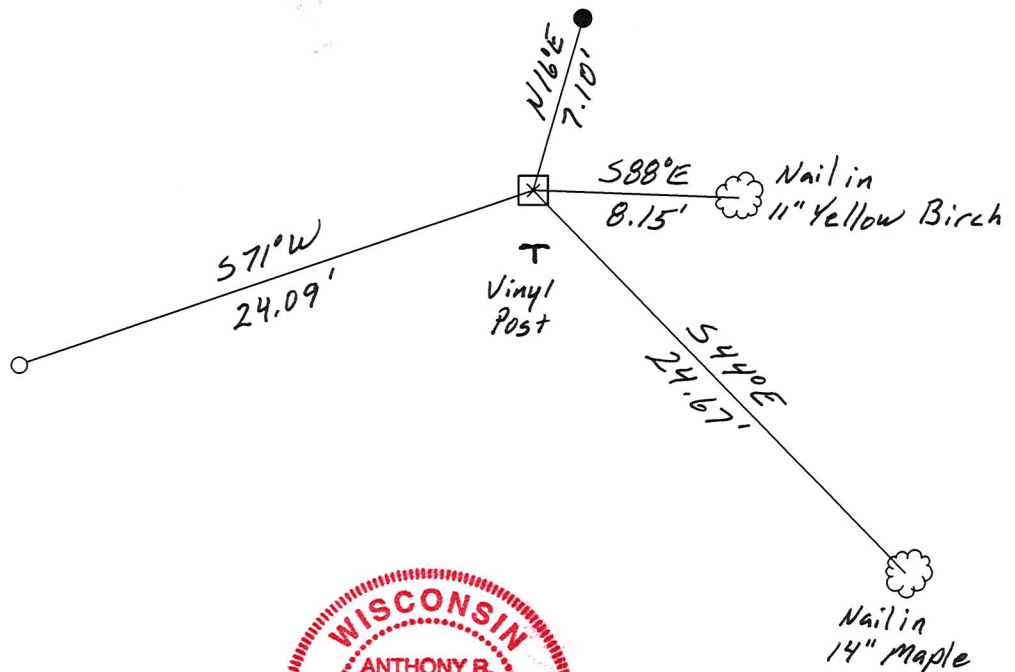

I, ANTHONY R. DALLMAN, WISCONSIN PROFESSIONAL LAND SURVEYOR, S-2405, HEREBY CERTIFY THAT THE CORNER LOCATION ON THIS RECORD WAS REFERENCED BY ME OR UNDER MY DIRECTION AND CONTROL AND THAT THIS U.S. PUBLIC LAND SURVEY MONUMENT RECORD IS COMPLETE TO THE BEST OF MY KNOWLEDGE AND BELIEF.

Anthony R. Dallman 8/23/19
 ANTHONY R. DALLMAN, PLS S-2405


*Woods Road
 ± 30' South of Corner*

INDEX NO. 69-17

U.S. PUBLIC LAND SURVEY MONUMENT RECORD

NOTE: This form is intended and designed to fulfill all requirements of Wisconsin Administrative Code, Chapter A-E 7.08 U.S. Public Land Survey Monument Record (3)(a)(b)(c)(d)(e)(f)(g)(h)(i). An additional sheet may be added if necessary to conform with said requirements.

(a) Corner location: Township 34 North
 Range 08 East
 Town of HARRISON
 LINCOLN County, Wisconsin

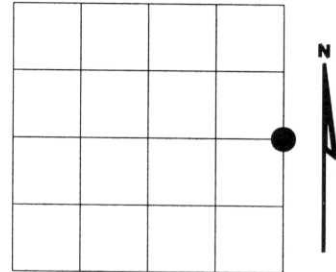

Section 10

(b)(f)(g)(h) Description of monument found at this corner and if it was accepted, state all evidence (material, testimonial, occupational, plats, records, other monuments) used as a basis for accepting. If not accepted or if nothing was found, state evidence used as basis for establishing location. If reestablished through lost corner proportionate methods, indicate all monuments, distances and directions used to establish. Indicate type of monument found or set and sign post.

1854 - Original Corner set by Jackson L. Prentice.

1938 - Francis Fuchs found very old 1/4 post and old rotted stump. Set 6"x6" granite stone mounded with rock.
 BTs: 4" Y. Birch N63°E, 40.3 Lks.
 5" Maple S71°W, 39.7 Lks.


1968 - Genisot & Associates found 6"x6" granite stone.
 BTs: 16" Maple S71°W, 25.9'
 9" Maple S44°E, 25.4'
 8" Y. Birch S88°E, 8.3'
 5" Y. Birch N10°E, 20.25'

2002 - I found 6"x6" granite stone in rock mound, 5" round post N70°E, 2.5'
 BTs found: Stump S71°W, 26.2' (F. Fuchs)
 7" Y. Birch N10°E, 20.25' (Genisot)
 9" Y. Birch S88°E, 8.5' (Genisot)
 12" Maple S44°E, 25.4' (Genisot)

Witness corner as shown below

RECEIVED AT LINCOLN COUNTY
 COURTHOUSE THIS 11TH DAY
 OF December 20 02
Tony Dallen
 LAND INFORMATION OFFICE

(c)(d)(e) Plan view of corner with ties to at least 4 witness monuments. If in disagreement with previously established corner, show the distances between the two corners and also indicate the ties to the disputed corner.

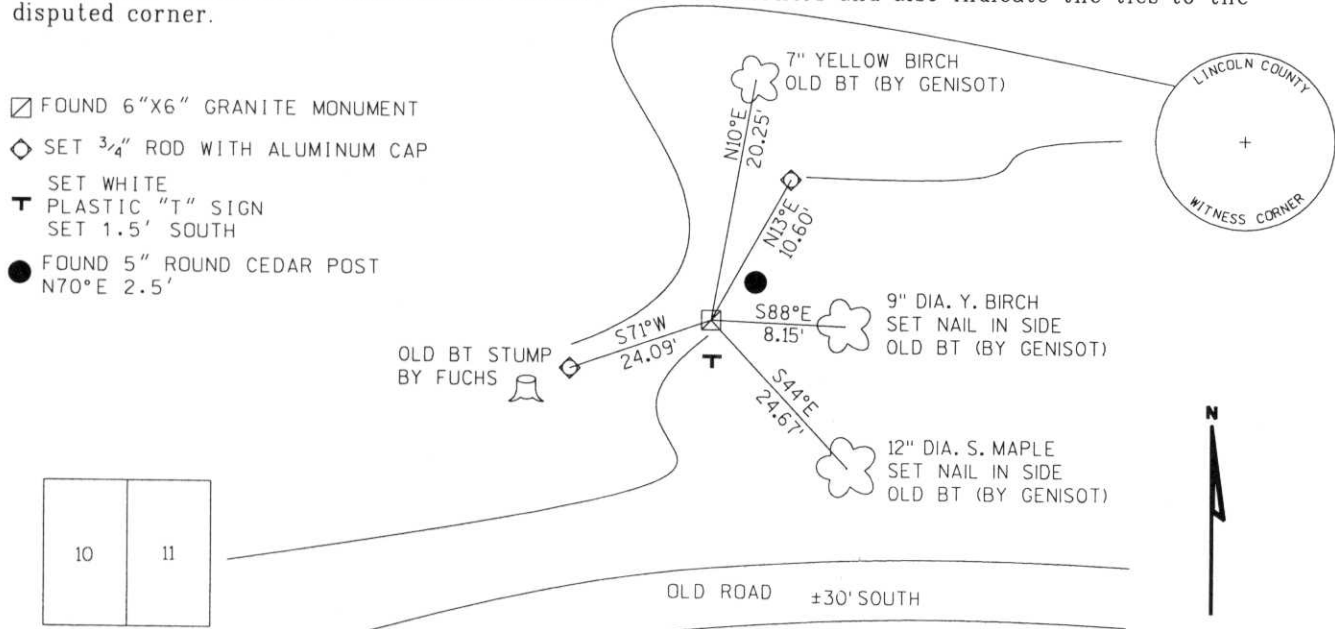

(i) I, Dennis B. Roberts, Registered Land Surveyor *S-1863, hereby certify that the corner location on this record was determined by me or under my direction and control and that this U.S. Public Land Survey Monument Record is correct and complete to the best of my knowledge and belief.



Dennis B. Roberts
 Signature

12-04-02
 Date

Index No. 6-12