



CERTIFIED LAND CORNER RESTORATION

Index No. M-15,14

State of Wisconsin }
County of LINCOLN } ss.

I WILLIAM IMMICH, do hereby
certify that on the 5th day
of DECEMBER, 1984, I found
evidence of the MEANDER
corner of SECTION 22
Township 34, North, Range
8 EAST, Fourth, Principal Meridian,
as described hereon; and that from this evidence
I established a new monument and accessories
as described hereon to perpetuate the original
location of this corner.

Resident witnesses:

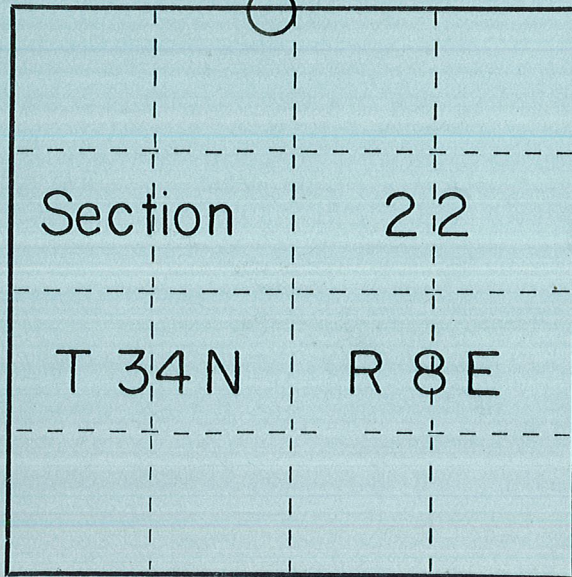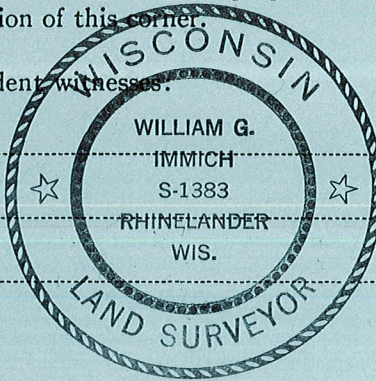

○ = Corner monument restored.

History of original corner establishment:

1854 JACKSON PRENTICE, GOVERNMENT SURVEYOR, WEST CORRECTED BETWEEN 15+22
42.00 CHAINS LEAVE LAKE SET MEANDER POST BTs, HEMLOCK 10N 50W 121K; HEMLOCK 20 54W 251K
1937 - F. FOX RAN BETWEEN 15-22 (EAST) 2355.6 SET M.C. ON
(EAST?) WEST SHORE "7 ISLAND" LAKE 3.9 NORTH 5' NORTH OF BOAT DOCK
1969 - WILLIAM CAMERON FOUND STONE M.C. NO BT's

Description of corner evidence found:

I FOUND STONE SET BY FOX IN PLACE.

Description of monument and accessories I established to perpetuate the original location of this corner.

FOUND STONE SET BY F. FOX, MONUMENT IN GOOD CONDITION SET 3/4" IRON PIPE
NEXT TO MONUMENT MADE NEW BEARING TREES*;

RED OAK	9"	N 6° E	26.95'
MAPLE	20"	N 45° W	47.50'
MAPLE	14"	S 53° W	30.30'
LAKE SHORE		EAST	7.0'

* BEARING MAG - DISTANCES TO FACE OF BLAZE

Dated at RHINELANDER, Wis., this 6 TH day of DECEMBER, 1984.

Signature William Immich Title _____ Registration No. _____
(County Surveyor, Registered Land Surveyor, or other duly authorized official)

Office of Register of Deeds, County of _____, I hereby certify that the within
instrument was filed in this office for record on the _____ day of _____, 19____
at _____ o'clock _____ M.

(Register of Deeds)

By _____ Deputy

43408150021