## U.S. PUBLIC LAND SURVEY MONUMENT RECORD


NOTE: This form is intended and designed to fulfill all requirements of Wisconsin Administrative Code, Chapter A-E 7 .08 U.S. Public Land Survey Monument Record (3)(a)(b)(c)(d)(e)(f) (g)(h)(i). An additional sheet may be added if necessary to conform with said requirements.

(a)Corner location: Township 34 North

Range 8 East

Harrison Town of \_\_\_

County of \_\_\_\_Lincoln

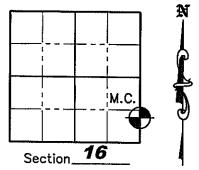

(b)(f)(g)(h) Description of monument found at this corner and if it was accepted, state all evidence (material, testimonial, occupation, plats, records, other monuments) used as a basis for accepting. If not accepted or if nothing was found, state evidence used as a basis for establishing location. If reestablished through lost corner proportionate methods, indicate all monuments, distances and directions used to establish. Indicate type of monument found or set and sign post.

November 1854 to December 1854— Prentice Jackson ran North between Section 15 and 16 -16.12 chains to lake and set Meander Post; BT's: Birch 10" N68E, 30 lks.; Maple 9" S10"W, 32 lks.


1938 - Francis Fox set stone at M.C.; BT's: Hemlock 7" S76"E 18.7"; Hemlock 10" Due South 12.8'

February 1969 - William Cameron found stone monument in place, but no bearing trees per Plat of Survey, Lincoln County Land Information Map Number L4B.

January 29, 1987 — William F. Kelly found 6" by 6" Granite Stone monument 5 feet from shore underwater. He set a 4" Aluminum Monument stamped: 15 feet North to M.C. He set 3 other bearing trees for the granite stone: 8" Yellow Birch S33"W, 15.70'; 16" Hemlock S06"W, 26.80'; 16" Hemlock S86°E, 19.30'

June 7, 2007 — Jonathan W. Dulin found a Lincoln County Bernsten Witness Monument set by William F. Kelly. The Corner was set as a witness corner and was stamped "15 feet North to M.C." which in 1987 was a found 6" by 6" Granite stone, 5 feet into Bass Lake. We also found 3 bearing trees with nails set in face, but the trees had grown over the nails. The 6" by 6" granite stone is now gone and was not remonumented as it fell in lake bed of Bass Lake. The existing Witness Corner lies on the Section line and we are now calling this the new Meander Corner. We set new 60 P nails in the side of two of the existing bearing trees we found and set two 7/8" by 30" iron rebar with aluminum caps as shown below. rebar with aluminum caps as shown below.

(c)(d)(e) Plan view of corner with ties to at least 4 witness monuments. If in disagreement with previously established corner, show the distances between the two corners and also indicate the ties to the disputed corner.

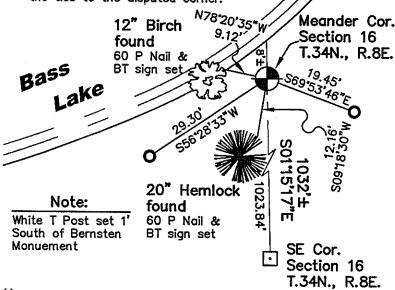

(i) I, Jonathan W. Dulin, certify that the corner location on this record was determined by me under my direction and control and that this U.S. Public Land Survey Monument is correct and complete to the best of the best o

Legend

- 7/8" by 30" Iron rebar with Aluminum Cap Set
- 6" by 6" Granite Stone lacksquarefound
- Lincoln County Bernsten Monument found



Scale: 1" =20'

RECEIVED BY LINCOLN COUNTY SURVEYOR THIS 28 TH DAY

OF October 20 08 Zony Dall COUNTY SURVEYOR

Sign¢\ture

DULIN RHINELANDER WISCONSIN WISCONSIN ON THE W

Date

-, III IVVUIIVIII	nded and designed to fulfill all requirements of Wisconsin Admin vey Monument Record (3) (a) (b) (c) (d) (e) (l) (g) (h) (i). An additio id requirements. Township 34 North	onal sheet may be added if necessary
•	1 Oth IsinpIYUIUI	
	Range8_East	
own	RISON	to the
CountyLINCO	/ N	
outly	14 (N	
		Section 16
not accepted or	ption of monument found at this corner and if it was onial, occupational, plats, records, other monuments) If nothing was found, state evidence used as ba- rough lost corner proportionate methods, indicate a o establish.	used as a basis for accepting. I
FOUND IN PLA	CE: 6x6 GRANITE STONE MONTH	
	CE: 6x6 GRANITE STONE MONUMENT, 5' FROM	SHORE, UNDERWATER
	SET 4" ALUMINUM CAP MEANDER CORNER.	
* I		
		• "
*		
		*
established corner disputed corner.	f corner with ties to at least 4 witness monuments. If in r, show the distances between the two corners and	n disagreement with previously
eispated comer.		maiodio ina ilea lo ille
Cisputed Cottler.		and maiodio the ties to the
/		and maiodio the ties to the
disputed Coffier.		and the ties to the
Conten conten.		and maiodia ina iles 10 ille
Conten Conten.	6"x6" GRANITE STONE (UNDERWATER)	LINCOLN COUNTY
Tisputed Collier.	L"LG" GRANITE STONE (UNDERWATER)	LINCOLN COUNTY
HZZZ	BASS LAKE  (BIS STONE  (UNDERWATER)  BASS LAKE  (BIS STONE  (UNDERWATER)  (UNDERWATER)  (UNDERWATER)	LOLN COUNTY  LOR DISTURBING MARKEY  ALTHURS  M.C. MARKEY
Vorter Collier.	BASS LAKE  (BISTS)  SBEE  188  16"HEMLOCK  188  188  188  188  188  188  188  1	LOUN COUNTY  LOUN
Haspated Collier.	BASS LAKE  (BIS STONE  (UNDERWATER)  BASS LAKE  (BIS STONE  (UNDERWATER)  (UNDERWATER)  (UNDERWATER)	COR COUNTY GOR DISTURBING MARKED M.C.
Noerth Collier.	BASS LAKE (BISTS) SBGE THE STONE (UNDERWATER)  BASS LAKE (BISTS) SBGE THE STONE (UNDERWATER)  BY 4 ELLOW BIRCH (N)	LIN COUNTY  FOR DISTURBATE  LOR MARKA  M.C. RA  M.C. RA  ENT-MC
North Collier.	BASS LAKE (BISTS) SBGE THE STONE (UNDERWATER)  BASS LAKE (BISTS) SBGE THE STONE (UNDERWATER)  BY 4 ELLOW BIRCH (N)	LIN COUNTY  FOR DISTURBATION  FOR MARKED  M.C. RES  ENT-MC
Мокти	BASS LAKE (B) SOME - TO A ALUMINUM MONUME B" YELOW BIRCH ) IS HEMLOCK	LIN COUNTY  FOR DISTURBATION  FOR MARKED  M.C. RES  ENT-MC
WILLIAM.	BASS LAKE (BISTS) SBGE THE STONE (UNDERWATER)  BASS LAKE (BISTS) SBGE THE STONE (UNDERWATER)  BY 4 ELLOW BIRCH (N)	LIN COUNTY  FOR DISTURBATION  FOR MARKED  M.C. RES  ENT-MC

Signature