

MINN CAPITAL SURVEYING, INC.
 SURVEY MONUMENT LOCATION RECORD

LANDMARK BENCHMARK
 CORNER IDENTITY W 1/4 COR
 DATE OF SURVEY Oct 21, 1974
 WEATHER CLEAR, BREEZY
 TEMPERATURE 50+
 SURVEY PARTY D. TUSTY D. MATTINGLY

FOUND
 SET
 RE-SET
 RE-TIED


SECTION 16
 TOWNSHIP 34N
 RANGE 8E
HARRISON
 TOWNSHIP
LINCOLN



BASIS FOR MONUMENT LOCATION
 DESCRIBE METHOD OF SURVEY AND CORNER AUTHENTICATION

SEE SURVEY FOR PAT BUCKETT SW-NW SEC 16-34N-8E

TIE SKETCH SHOW HORIZONTAL TIE DISTANCES TO FIXED WITNESS MONUMENTS. DESCRIBE ALL MONUMENTS FOUND OR SET

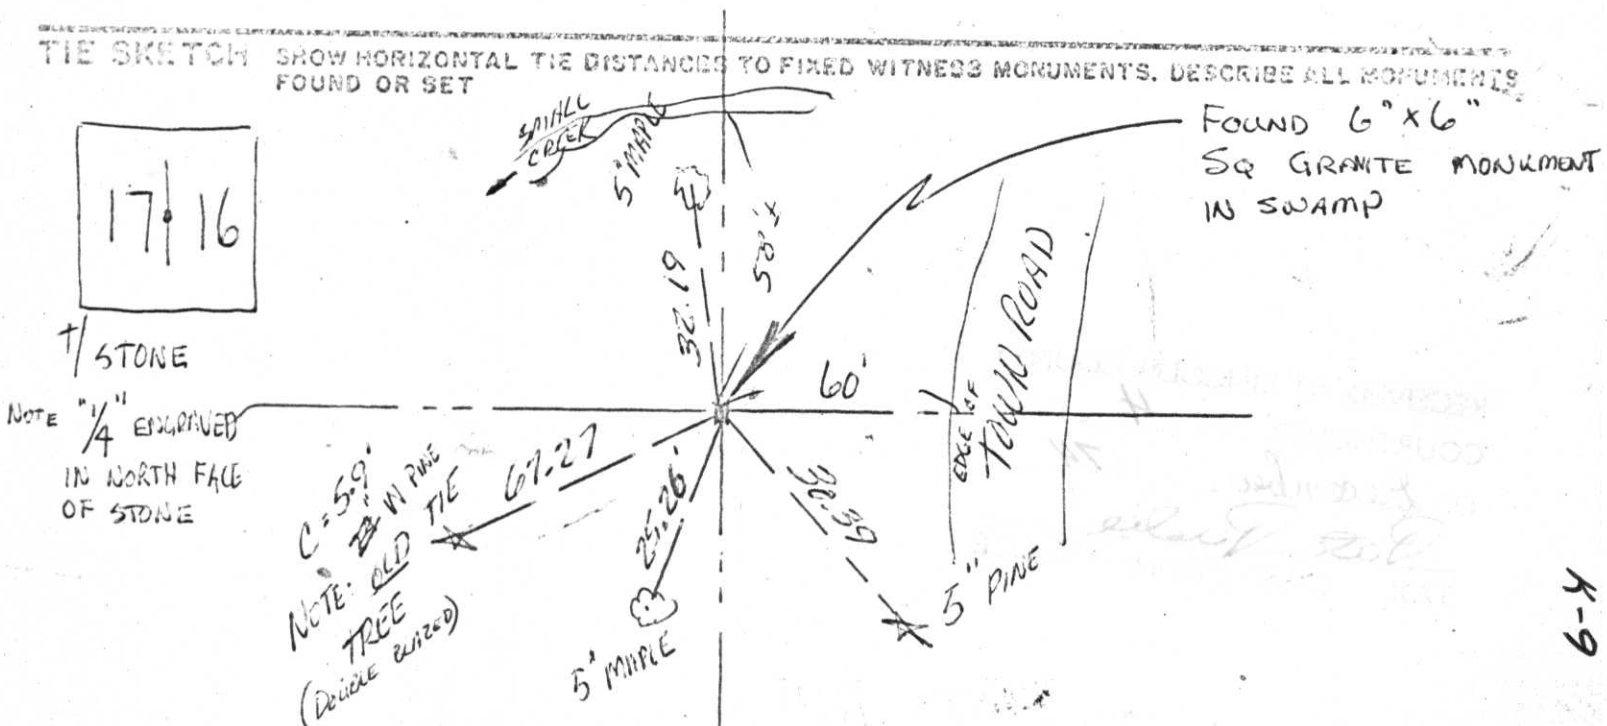

16-34-8E

K-9