




CERTIFIED LAND CORNER RESTORATION

Index No. 0-13

State of Wisconsin }  
County of LINCOLN } ss.

I WILLIAM IMMICH, do hereby certify that on the 5th day of DECEMBER, 1984, I found evidence of the WEST 1/4 corner of SECTION 22 Township 34, North, Range 8 EAST, Fourth, Principal Meridian, as described hereon; and that from this evidence I established a new monument and accessories as described hereon to perpetuate the original location of this corner.

Resident witness:

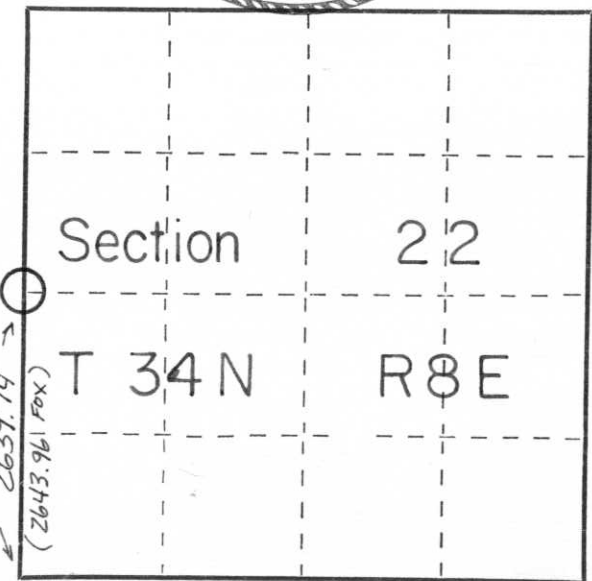

2639.74'  
(2643.96' FOX)

○ = Corner monument restored.

History of original corner establishment:

1854 JACKSON PRENTICE, GOVERNMENT SURVEYOR, NORTH BETWEEN 21-22 40.00 CHAINS SET QUARTER POST B.T.S, HEMLOCK 8 N 85 E 81k, BIRCH 10 S 75 W 381k  
1937 - F. FOX FOUND VERY OLD STAKE AND ORIGINAL B.T. SET STONE ACCORDINGLY

Description of corner evidence found:

I FOUND F. FOX'S STONE IN PLACE

Description of monument and accessories I established to perpetuate the original location of this corner.

FOUND STONE SET BY F. FOX IN GOOD CONDITION SET 3/4" IRON PIPE NEXT TO STONE, SET GREEN AND WHITE POST SOUTHEAST 2.0', MADE BEARING TREES\*

RED OAK	16"	S 61° W	14.90'
RED OAK	12"	N 14° W	18.00'
MAPLE	6"	N 79° E	31.30'

\* BEARINGS MAG. - DISTANCE TO FACE OF BLAZE

Dated at RHINELANDER, Wis., this 6th day of DECEMBER, 1984.

Signature William Immich Title Registered Land Surveyor Registration No. 1383  
(County Surveyor, Registered Land Surveyor, or other duly authorized official)

Office of Register of Deeds, County of \_\_\_\_\_, I hereby certify that the within instrument was filed in this office for record on the \_\_\_\_\_ day of \_\_\_\_\_, 19\_\_\_\_ at \_\_\_\_\_ o'clock \_\_\_\_\_ M.

(Register of Deeds)

By \_\_\_\_\_ Deputy