


U.S. PUBLIC LAND SURVEY MONUMENT RECORD

Note: This form is intended and designed to fulfill all requirements of Wisconsin Administrative Code, Chapter A-E 7.08, U.S. Public Land Survey Monument Record (3) (a) (b) (c) (d) (e) (f) (g) (h) (i). An additional sheet may be added if necessary to conform with said requirements.

(a) Corner location: Township 34 North
 Range 8 East
 Town ~~/City/Village~~ HARRISON
 County Lincoln

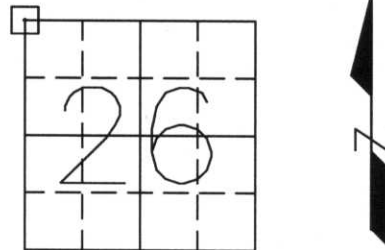


(b) (f) (g) (h) Description of monument found at this corner and if it was accepted, state all evidence (material, testimonial, occupational, plats, records, other monuments) used as a basis for accepting. If not accepted or if nothing was found, state evidence used as basis for establishing location. If reestablished through lost corner proportionate methods, indicate all monuments, distances and directions used to establish.

1854 - Jackson L. Prentice established 1/4 section post, witnessed by:
 Pine 10, S45°E, 35 links
 Hemlock 10, S65°W, 31 links
 Hemlock 8, N85°E, 30 links
 Hemlock 10, N60°W, 10 links

1938 - Francis X. Fox set granite monument by double proportionate measure, witnessed by:
 W. Pine 5, N60°E, 26.5 feet
 N. Pine 6, S22°E, 25.4 feet

2000 - Found granite monument, witnessed as shown below.

(c) (d) (e) Plan view of corner with ties to at least 4 witness monuments. If in disagreement with previously established corner, show the distance between the two corners and also indicate the ties to the disputed corner.

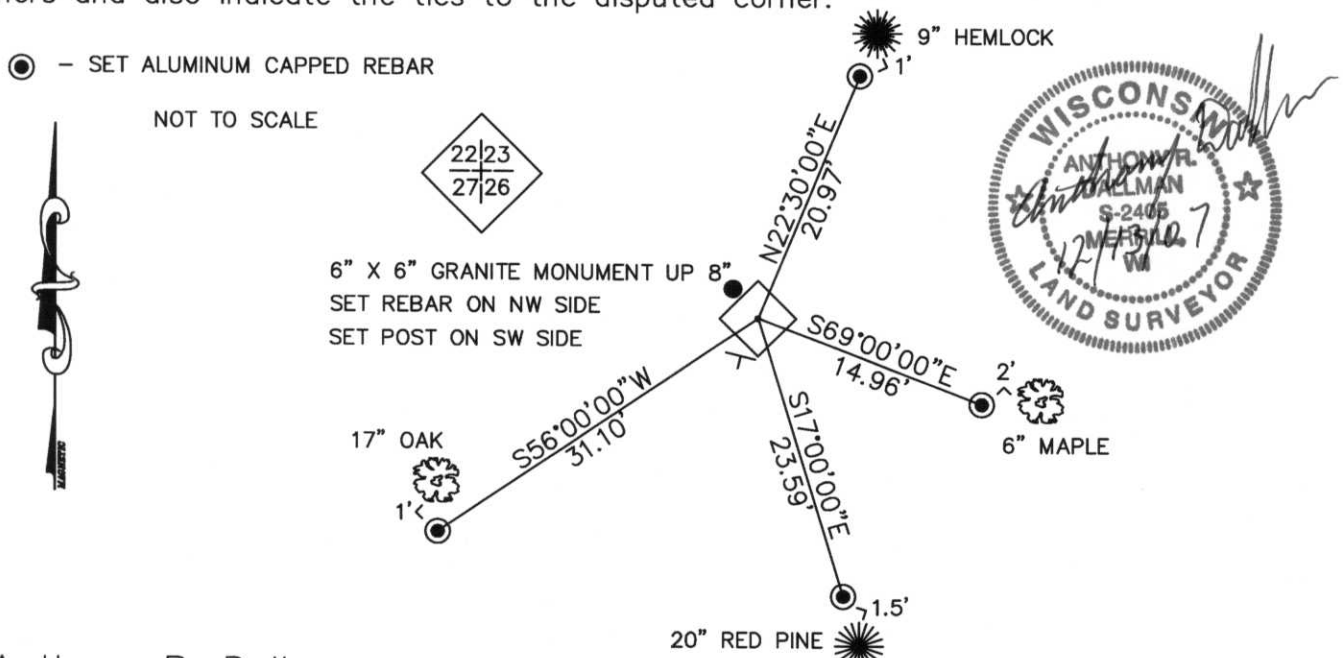

(i) I, Anthony R. Dallman
 (type or print name) certify that the corner location on this record was determined by me or under my direction and control and that this U.S. Public Land Survey Monument Record is correct and complete to the best of my knowledge and belief.

Anthony R. Dallman Signature 12/13/07 Date

Index No. Q-17