

CERTIFIED LAND CORNER RESTORATION

Index No. Q-21


State of Wisconsin }  
County of LINCOLN } ss.

I, William F. Kelly, do hereby certify that on the 6<sup>TH</sup> day of NOVEMBER, 1974, I found evidence of the NORTH WEST corner of SECT 25 Township 34 N, North, Range 8 E, Fourth, Principal Meridian, as described hereon; and that from this evidence I established a new monument and accessories as described hereon to perpetuate the original location of this corner.

Resident witnesses:

R. E POND


L. POND

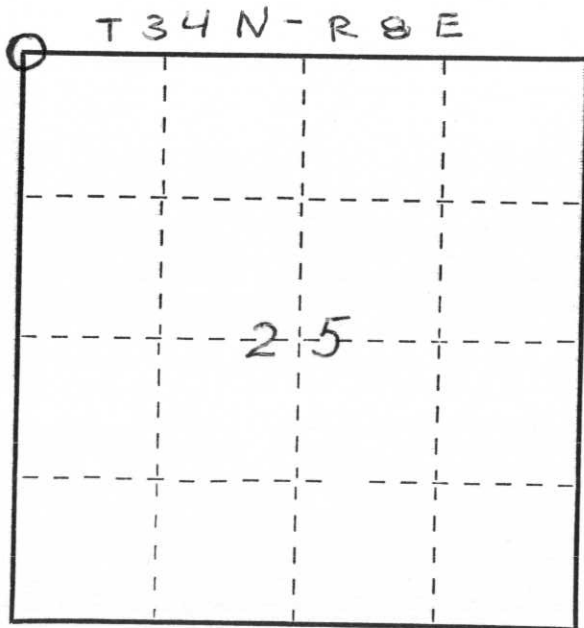

○ = Corner monument restored.

History of original corner establishment:

NOTE: GRANITE MON. SET IN THE 1920'S PER AREA RESIDENT

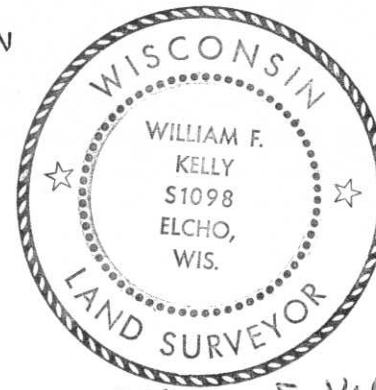


*William F. Kelly*

Description of corner evidence found:

I LOCATED A GRANITE STONE MONUMENT SCRIBED MON. IS 6" SQUARE X 30" SET IN A PILE OF STONES. LINES RUNNING WEST AND NORTH OF MON. BLAZED. MON IS IN EXCELLANT COND.

I SET THE NEW MON. AS A WITNESS CORNER 1 FT WEST OF THE GRANITE STONE. MON. MARKED

Description of monument and accessories I established to perpetuate the original location of this corner.

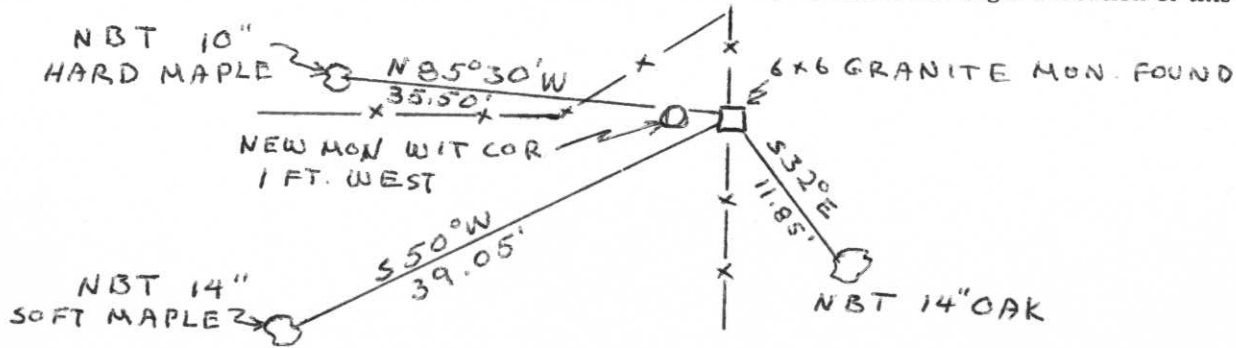

23	24
26	25

WIT. MON  
SECT COR  
23 | 24  
26 | 25  
T34N R8E  
COR 1FTE  
WFK

Dated at ELCHO, Wis., this 6<sup>TH</sup> day of NOVEMBER, 1974

Signature William F. Kelly Title REG. LAND SURVEYOR Registration No. S-1098  
(County Surveyor, Registered Land Surveyor, or other duly authorized official)

Office of Register of Deeds, County of \_\_\_\_\_, I hereby certify that the within instrument was filed in this office for record on the \_\_\_\_\_ day of \_\_\_\_\_, 19\_\_\_\_ at \_\_\_\_\_ o'clock \_\_\_\_\_ M.

(Register of Deeds)

By \_\_\_\_\_ Deputy