

# U.S. PUBLIC LAND SURVEY MONUMENT RECORD

NOTE: THIS FORM IS INTENDED AND DESIGNED TO FULFILL ALL REQUIREMENTS OF WISCONSIN ADMINISTRATIVE CODE, CHAPTER A-E 7.08, U.S. PUBLIC LAND SURVEY MONUMENT RECORD (3)(a)(b)(c)(d)(e)(f)(g)(h)(i). ADDITIONAL SHEETS MAY BE NECESSARY TO CONFORM TO SAID REQUIREMENTS.


T 34 N, R 8 E

**(a) CORNER LOCATION:**

NORTH QUARTER CORNER, SECTION 26  
 TOWNSHIP 34 NORTH  
 RANGE 8 EAST  
 TOWN OF HARRISON  
 LINCOLN COUNTY  
 WISCONSIN

**(b) HISTORY OF ORIGINAL CORNER:**

ORIGINAL SURVEYOR: James M. Marsh, Set post  
 COMMENCING DATE: July 29, 1851  
 COMPLETION DATE: August 11, 1851  
 ORIGINAL BEARING TREES:  
 10" Hemlock; S 16° W; 27 links  
 16" Pine; S 10° E; 15 links

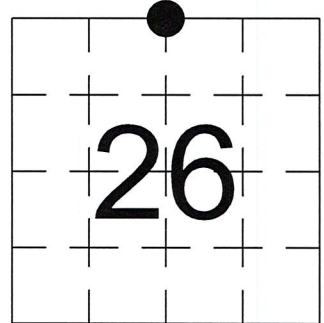

**(f)(g)(h) DESCRIPTION OF MONUMENT FOUND AT THIS CORNER AND IF IT WAS ACCEPTED. STATE ALL EVIDENCE (MATERIAL, TESTIMONIAL, OCCUPATIONAL, PLATS, RECORDS, OTHER MONUMENTS) USED AS A BASIS FOR ESTABLISHING LOCATION. IF RE-ESTABLISHING THROUGH LOST CORNER PROPORTIONATE METHODS, INDICATE ALL MONUMENTS, DISTANCES, AND DIRECTIONS USED TO ESTABLISH. INDICATE TYPE OF MONUMENTS FOUND OR SET.**



1930's, Francis Fox set  $\frac{1}{4}$  Stone at proportion measurement.

11/26/1974, William Kelly, found Fox's 6" x 6" Granite Stone Monument and set reference ties.


5/13/2019, I, Anthony R. Dallman, PLS-2405, found a 6" x 6" Granite Monument up 10" and all of Kelly's ties. I accepted this location and set a new reference ties to further perpetuate the corner location as shown in the sketch below.

**(c)(d)(e) PLAN VIEW OF THE CORNER WITH TIES TO AT LEAST FOUR WITNESSES. IF IN DISAGREEMENT WITH PREVIOUSLY ESTABLISHED CORNER, SHOW THE DISTANCES BETWEEN THE TWO CORNERS AND ALSO THE TIES TO THE DISPUTED CORNER.**

- Tie bearings by hand-held compass.
- Tie distances by steel tape.
- Not to scale.

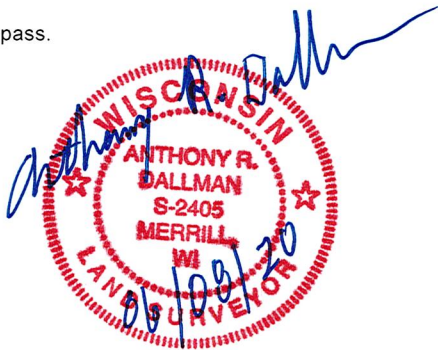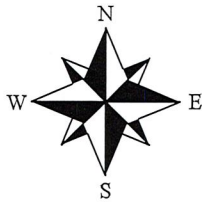

● - Set 7/8" Capped Rebar

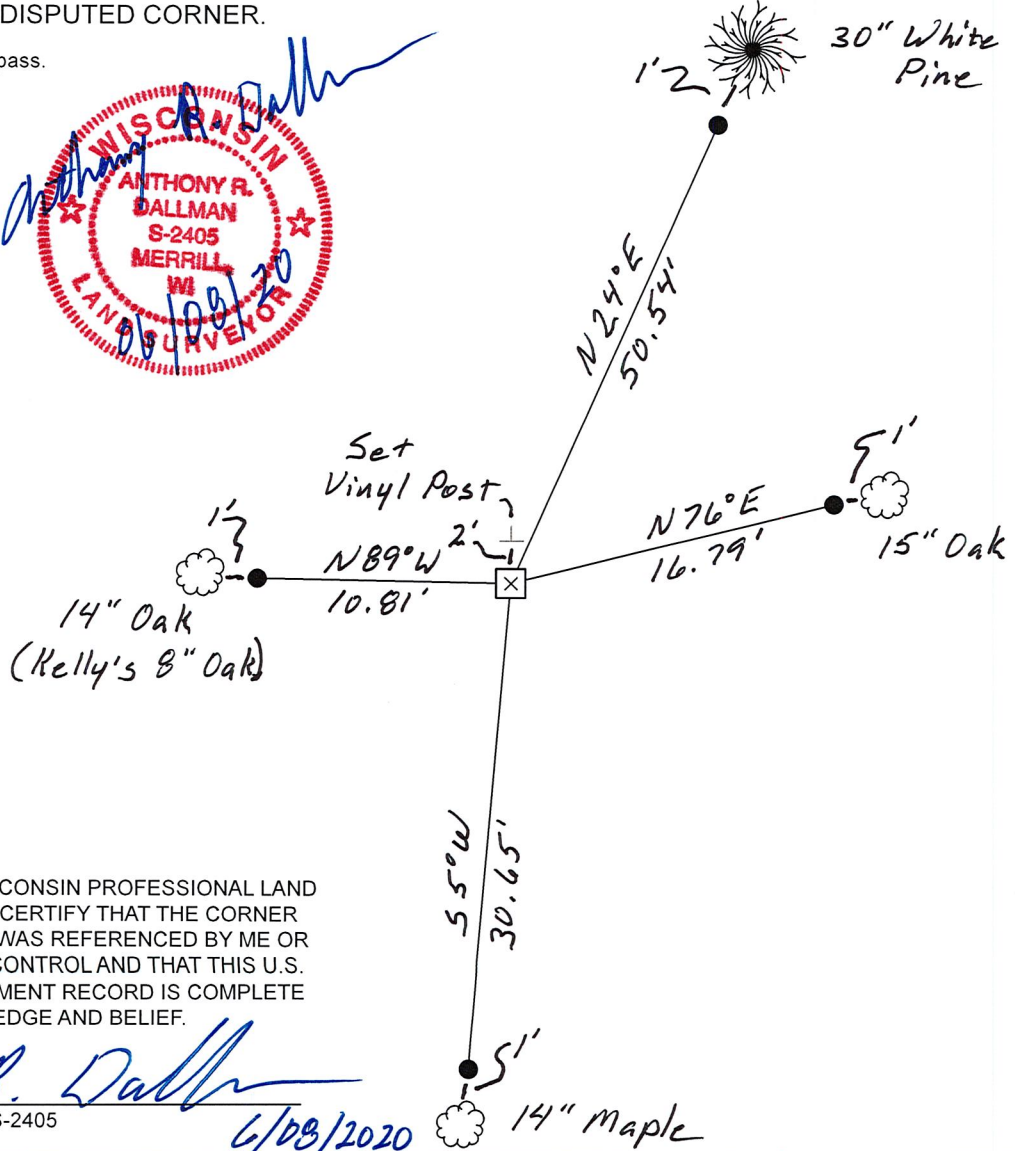

I, ANTHONY R. DALLMAN, WISCONSIN PROFESSIONAL LAND SURVEYOR, S-2405, HEREBY CERTIFY THAT THE CORNER LOCATION ON THIS RECORD WAS REFERENCED BY ME OR UNDER MY DIRECTION AND CONTROL AND THAT THIS U.S. PUBLIC LAND SURVEY MONUMENT RECORD IS COMPLETE TO THE BEST OF MY KNOWLEDGE AND BELIEF.

*Anthony R. Dallman*  
 ANTHONY R. DALLMAN, PLS S-2405  
 6/08/2020

INDEX NO. Q - 19

CERTIFIED LAND CORNER RESTORATION

Index No. Q-19

State of Wisconsin }  
 County of LINCOLN } ss.

I WILLIAM F. KELLY, do hereby certify that on the 26<sup>th</sup> day of NOVEMBER, 1974, I found evidence of the 1/4 SECTION corner of SECTION 23 & 26 Township 34, North, Range 8 East, Fourth, Principal Meridian, as described hereon; and that from this evidence I established a new monument and accessories as described hereon to perpetuate the original location of this corner.


Resident witnesses:

.....

.....

.....

History of original corner establishment:

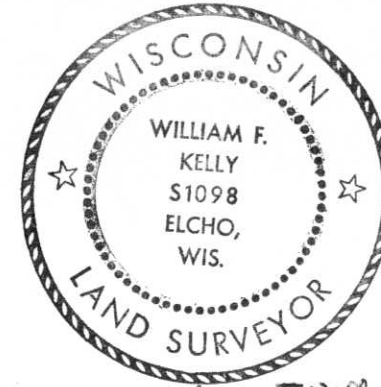


*William F. Kelly*


Description of corner evidence found:

LOCATED 6" x 6" GRANITE STONE MONUMENT MARKED 23  
+  
26 SET IN PILE OF STONES WITH A WITNESS POST.

Description of monument and accessories I established to perpetuate the original location of this corner.

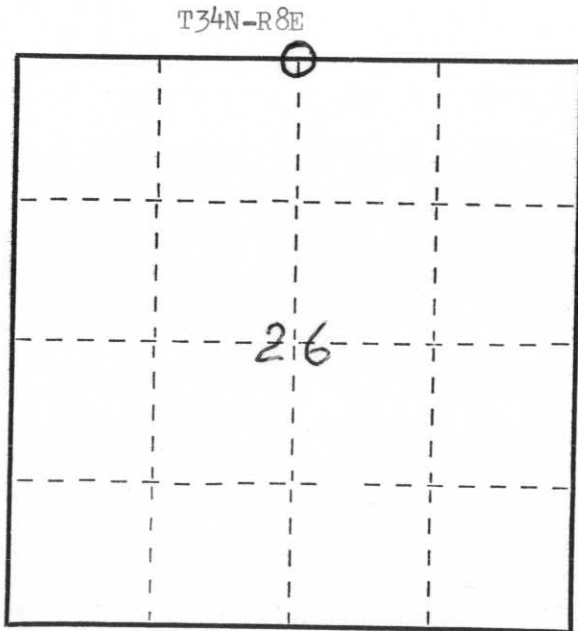

○ = Corner monument restored.

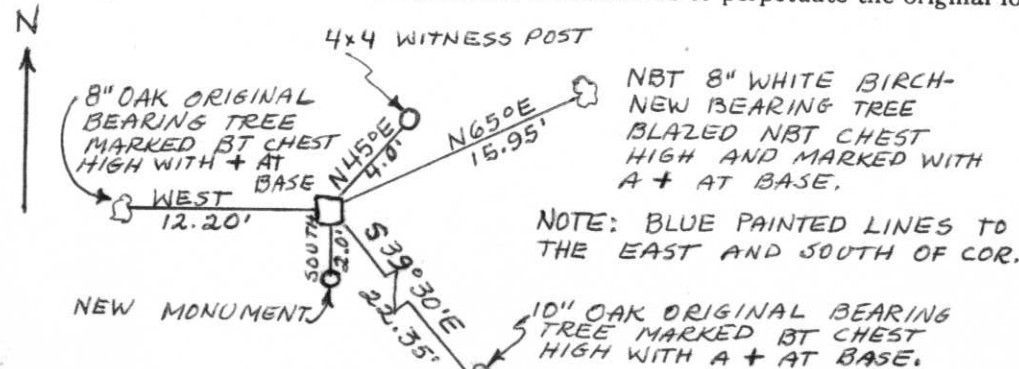

NOTE: BLUE PAINTED LINES TO THE EAST AND SOUTH OF COR.

I SET NEW MONUMENT FLUSH WITH THE GROUND 2 FT. SOUTH OF THE CORNER.



Dated at ELCHO, Wis., this 26<sup>th</sup> day of NOVEMBER, 1974.

Signature William F. Kelly Title REGISTERED LAND SURVEYOR Registration No. S 1098  
 (County Surveyor, Registered Land Surveyor, or other duly authorized official)

Office of Register of Deeds, County of \_\_\_\_\_, I hereby certify that the within instrument was filed in this office for record on the \_\_\_\_\_ day of \_\_\_\_\_, 19\_\_\_\_ at \_\_\_\_\_ o'clock \_\_\_\_\_ M.

(Register of Deeds)

By \_\_\_\_\_ Deputy