

CERTIFIED LAND CORNER RESTORATION

Index No. U-21

State of Wisconsin }
 County of LINCOLN } ss.

History of original corner establishment:

I WILLIAM F. KELLY, do hereby certify that on the 26th day of NOVEMBER, 19 74, I found evidence of the SECTION CORNER corner of SECTION 26, 25, 35 & 36 Township 34, North, Range 8 East, Fourth, Principal Meridian, as described hereon; and that from this evidence I established a new monument and accessories as described hereon to perpetuate the original location of this corner.

Description of corner evidence found:

FOUND WITNESS CORNER POST 1 ROD NORTH OF SECTION CORNER.

Resident witnesses:



R. Hanson

N. Dirks



William F. Kelly

Description of monument and accessories I established to perpetuate the original location of this corner.

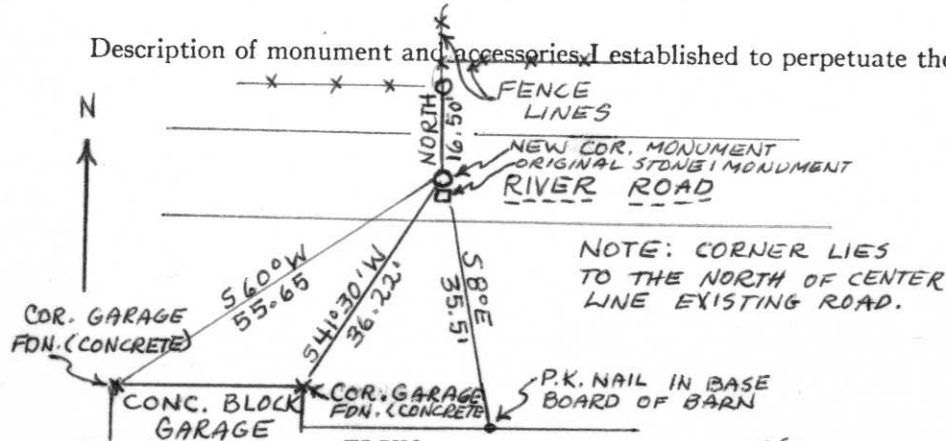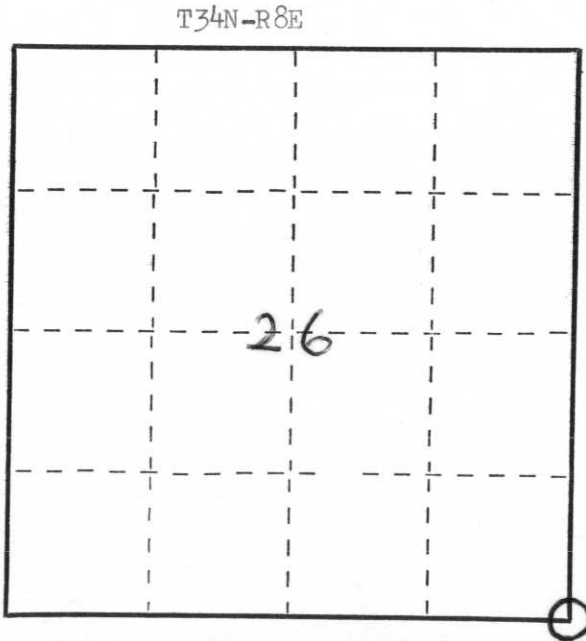

NOTE: CORNER LIES TO THE NORTH OF CENTER LINE EXISTING ROAD.

SET CORNER MONUMENT IN ROAD 6" UNDER SURFACE. ORIGINAL STONE MONUMENT BURIED IN ROADWAY.



Dated at ELCHO, Wis., this 26th day of NOVEMBER, 19 74.

Signature William F. Kelly Title REGISTERED LAND SURVEYOR Registration No. S 1098
 (County Surveyor, Registered Land Surveyor, or other duly authorized official)

Office of Register of Deeds, County of _____, I hereby certify that the within instrument was filed in this office for record on the _____ day of _____, 19 _____ at _____ o'clock _____ M.

(Register of Deeds)

By _____ Deputy

○ = Corner monument restored.