

U.S. PUBLIC LAND SURVEY MONUMENT RECORD

NOTE: THIS FORM IS INTENDED AND DESIGNED TO FULFILL ALL REQUIREMENTS OF WISCONSIN ADMINISTRATIVE CODE, CHAPTER A-E 7.08, U.S. PUBLIC LAND SURVEY MONUMENT RECORD (3)(a)(b)(c)(d)(e)(f)(g)(h)(i). ADDITIONAL SHEETS MAY BE NECESSARY TO CONFORM TO SAID REQUIREMENTS.


T 34 N, R 8 E

(a) CORNER LOCATION:

EAST QUARTER CORNER, SECTION 26
 TOWNSHIP 34 NORTH
 RANGE 8 EAST
 TOWN OF HARRISON
 LINCOLN COUNTY
 WISCONSIN

(b) HISTORY OF ORIGINAL CORNER:

ORIGINAL SURVEYOR: Jackson L. Prentice, Set post
 COMMENCING DATE: November 27, 1854
 COMPLETION DATE: December 11, 1854
 ORIGINAL BEARING TREES:
 13" Pine; N 57° E; 33 links
 10" Maple; S 88° W; 19 links

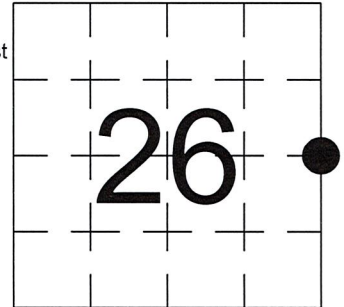

(f)(g)(h) DESCRIPTION OF MONUMENT FOUND AT THIS CORNER AND IF IT WAS ACCEPTED. STATE ALL EVIDENCE (MATERIAL, TESTIMONIAL, OCCUPATIONAL, PLATS, RECORDS, OTHER MONUMENTS) USED AS A BASIS FOR ESTABLISHING LOCATION. IF RE-ESTABLISHING THROUGH LOST CORNER PROPORTIONATE METHODS, INDICATE ALL MONUMENTS, DISTANCES, AND DIRECTIONS USED TO ESTABLISH. INDICATE TYPE OF MONUMENTS FOUND OR SET.


1937, Francis X. Fuchs(Fox) set Granite Monument at identified $\frac{1}{4}$ Corner.

1974, William Kelly, found Granite Monument and set reference ties.

5/29/2019, I, Anthony R. Dallman, PLS-2405, found the 6" X 6" Granite, up 9", and 3 of Kelly's ties. I accepted this location and set new reference ties to further perpetuate the corner location as shown in the sketch below.


(c)(d)(e) PLAN VIEW OF THE CORNER WITH TIES TO AT LEAST FOUR WITNESSES. IF IN DISAGREEMENT WITH PREVIOUSLY ESTABLISHED CORNER, SHOW THE DISTANCES BETWEEN THE TWO CORNERS AND ALSO THE TIES TO THE DISPUTED CORNER.

- Tie bearings by hand-held compass.
- Tie distances by steel tape.
- Not to scale.

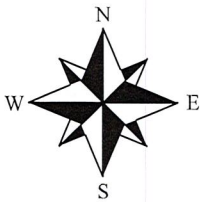

● - Set 7/8" Capped Rebar

○ - Found 1" Iron Pipe

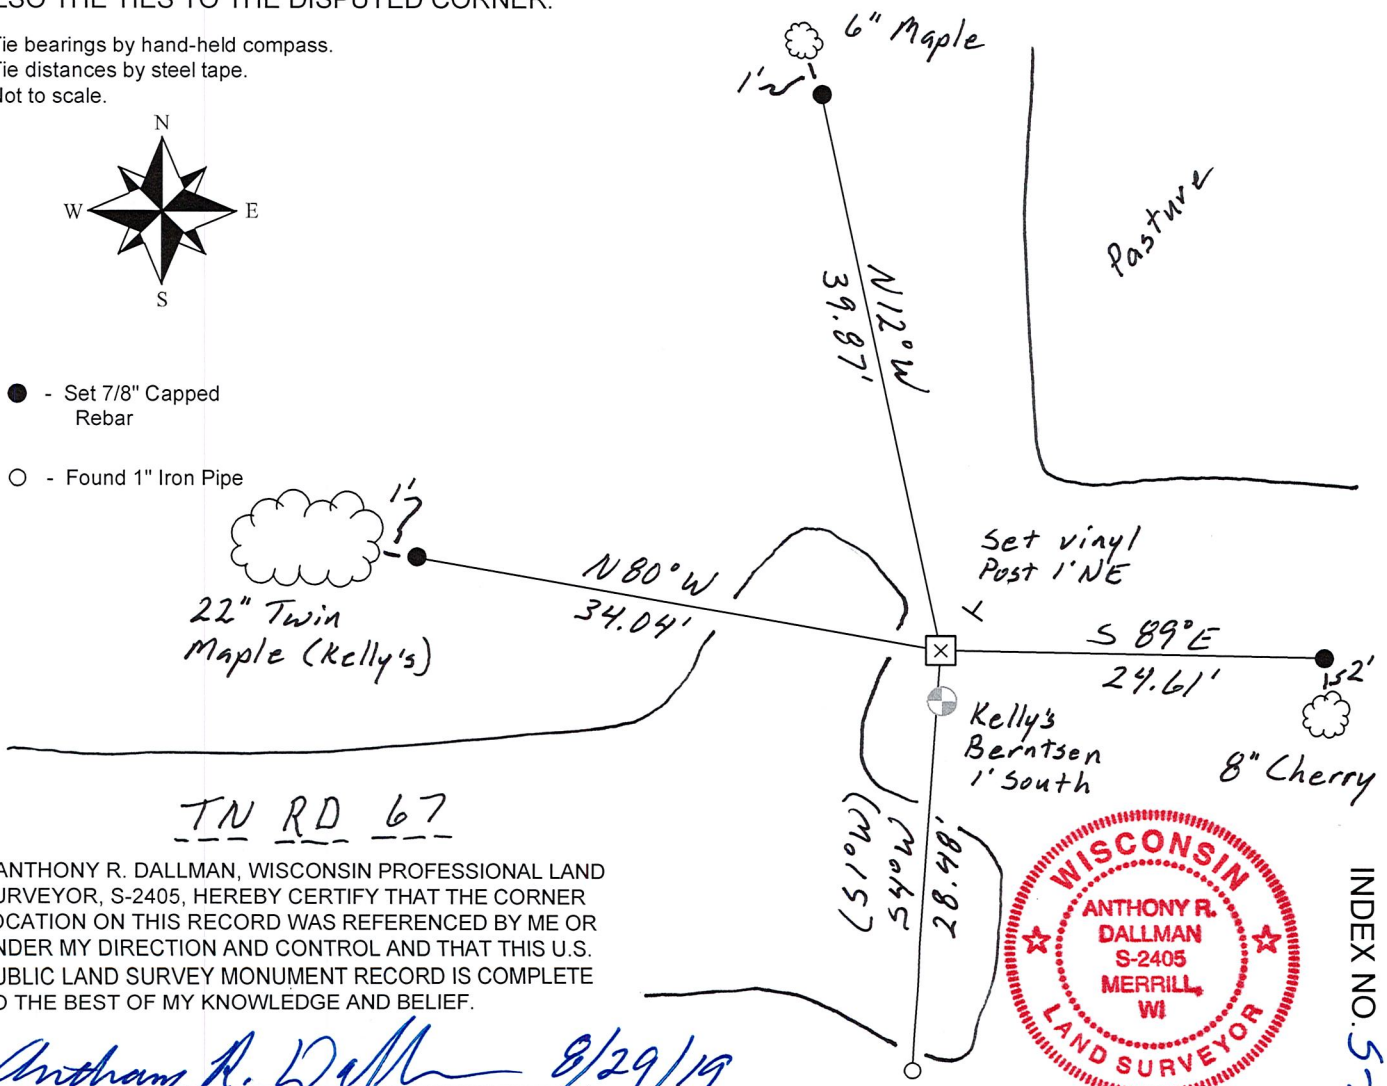

I, ANTHONY R. DALLMAN, WISCONSIN PROFESSIONAL LAND SURVEYOR, S-2405, HEREBY CERTIFY THAT THE CORNER LOCATION ON THIS RECORD WAS REFERENCED BY ME OR UNDER MY DIRECTION AND CONTROL AND THAT THIS U.S. PUBLIC LAND SURVEY MONUMENT RECORD IS COMPLETE TO THE BEST OF MY KNOWLEDGE AND BELIEF.

Anthony R. Dallman 8/29/19
 ANTHONY R. DALLMAN, PLS S-2405



INDEX NO. 5-21

CERTIFIED LAND CORNER RESTORATION

Index No. S-21

State of Wisconsin }
County of LINCOLN } ss.


I, William F. Kelly, do hereby certify that on the 6th day of NOVEMBER, 1974, I found evidence of the WEST 1/4 corner of SECT 25 Township 34, North, Range 8 E, Fourth, Principal Meridian, as described hereon; and that from this evidence I established a new monument and accessories as described hereon to perpetuate the original location of this corner.

Resident witnesses:

R. E. POND
N. Dirckx

History of original corner establishment:

NOTE: GRANITE MON. SET IN THE 1920'S PER AREA RESIDENT

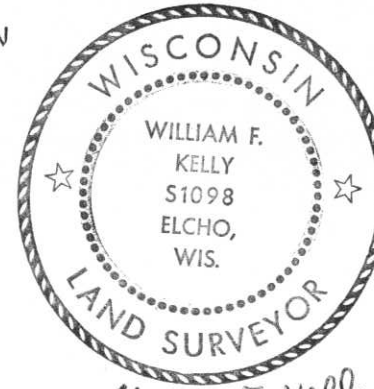

William F. Kelly

26+25



Description of corner evidence found:

I LOCATED A GRANITE STONE MONUMENT SCRIBED MON. IS 6" SQUARE X 30". MON. IS NEXT TO AN OLD POST THAT HAS ROTTED OUT.

THE MONUMENT LOCATED IS IN EXCELLANT CONDITION I SET THE NEW MON. AS A WITNESS CORNER 1 FT. SOUTH OF THE GRANITE STONE. THE NEW MON. IS SET FLUSH WITH THE GROUND. WIT. COR MARKED

Description of monument and accessories I established to perpetuate the original location of this corner.

NOTE: NEW BEARING TREE BLAZED AND SCRIBED NBT CHEST HIGH AND MARKED WITH A + AT BASE

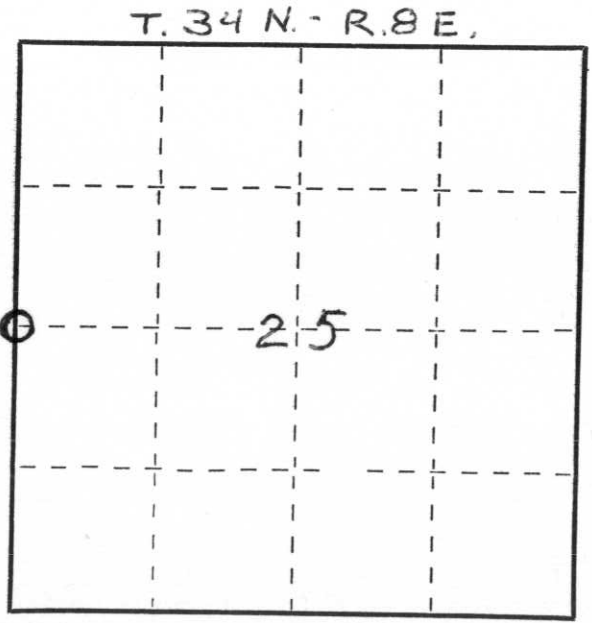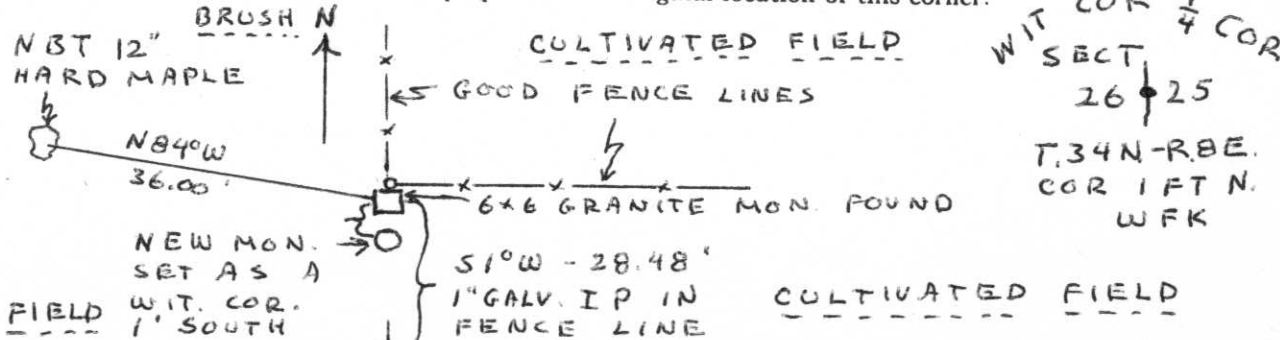

○ = Corner monument restored.

Dated at ELCHO, Wis., this 6th day of NOVEMBER, 1974.

Signature William F. Kelly Title REG. LAND SURVEYOR Registration No. S-1098
(County Surveyor, Registered Land Surveyor, or other duly authorized official)

Office of Register of Deeds, County of _____, I hereby certify that the within instrument was filed in this office for record on the _____ day of _____, 19____ at _____ o'clock _____ M.

(Register of Deeds)

By _____ Deputy