

Attachment to Tie Sheet S-17, T34N, R8E

43408272000

I visited the corner on 5/31/2019 to verify the corner and reference tie monumentation. I found the 6" X 6" Granite Monument and all 4 ties from the Anthony Dallman tie sheet (10/24/2000). The established Coordinates and ties agree with existing monument.

Anthony R. Dallman 8/29/19

Anthony R. Dallman, PLS-2405


Lincoln County Surveyor



U.S. PUBLIC LAND SURVEY MONUMENT RECORD

Note: This form is intended and designed to fulfill all requirements of Wisconsin Administrative Code, Chapter A-E 7.08, U.S. Public Land Survey Monument Record (3) (a) (b) (c) (d) (e) (f) (g) (h) (i). An additional sheet may be added if necessary to conform with said requirements.

(a) Corner location: Township 34 North
 Range 8 East
 Town/~~City~~/Village HARRISON
 County Lincoln

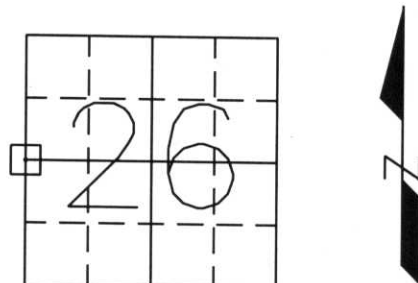

(b) (f) (g) (h) Description of monument found at this corner and if it was accepted, state all evidence (material, testimonial, occupational, plats, records, other monuments) used as a basis for accepting. If not accepted or if nothing was found, state evidence used as basis for establishing location. If reestablished through lost corner proportionate methods, indicate all monuments, distances and directions used to establish.

1854 - JACKSON L. PRENTICE SET WOOD POST WITNESSED BY (MAPLE 10 N 47 E 18 LINKS)
 (BIRCH 24 N 48 W 20 LINKS)

1937 - FRANCIS X. FUCHS SET 1/4 CORNER NOTHING TO WITNESS


2000 - FOUND 6" X 6" GRANITE MONUMENT MARKED AS SHOWN BELOW.



(c) (d) (e) Plan view of corner with ties to at least 4 witness monuments. If in disagreement with previously established corner, show the distance between the two corners and also indicate the ties to the disputed corner.

● - SET ALUMINUM CAPPED REBAR

NOT TO SCALE

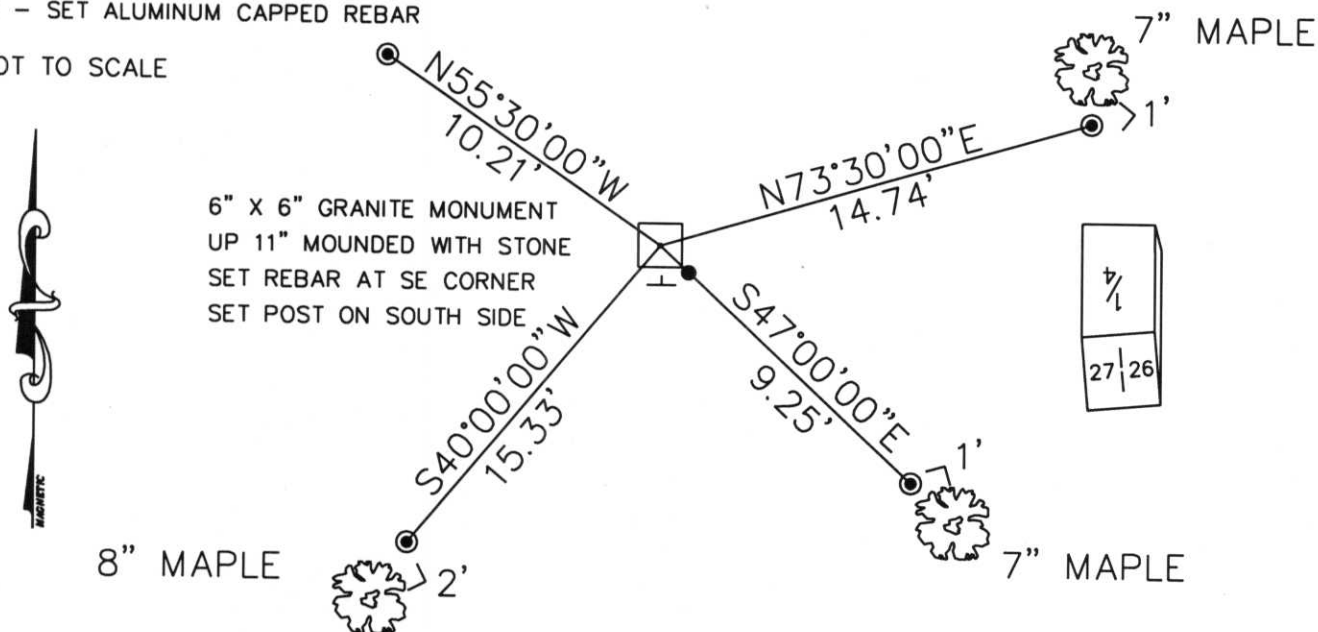

(i) I, Anthony R. Dallman

(type or print name) certify that the corner location on this record was determined by me or under my direction and control and that this U.S. Public Land Survey Monument Record is correct and complete to the best of my knowledge and belief.

Anthony Dallman
 Signature

10/24/00
 Date

Index No. 5-17