


# U.S. PUBLIC LAND SURVEY MONUMENT RECORD

**Note:** This form is intended and designed to fulfill all requirements of Wisconsin Administrative Code, Chapter A-E 5.02, U.S. Public Land Survey Monument Record (3) (a) (b) (c) (d) (e) (f) (g) (h) (i). An additional sheet may be added if necessary to conform with said requirements.

(a) Corner location: Township 33 North  
 Range 8 East

Town RUSSELL

County LINCOLN

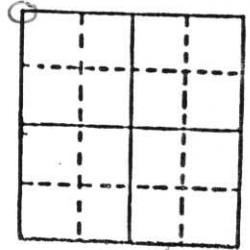


Section 4

b) (f) (g) (h) Description of monument found at this corner and if it was accepted, state all evidence (material, testimonial, occupational, plats, records, other monuments) used as a basis for accepting. If not accepted or if nothing was found, state evidence used as basis for establishing location. If reestablished through lost corner proportionate methods, indicate all monuments, distances and directions used to establish.

*GRANITE POST, FOUND BLAZE LINE SOUTH OF CORNER*

c) (d) (e) Plan view of corner with ties to at least 4 witness monuments. If in disagreement with previously established corner, show the distances between the two corners and also indicate the ties to the disputed corner.

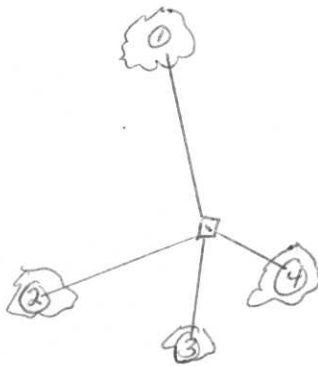

*BEARING TREES NW CORNER 4-33-8*

- ① 14" HARD MAPLE N10°W 21.8'
- ② 10" " " S70°W 25.9'
- ③ 8" " " S7°W 16.6'
- ④ 7" " " S48°E 10.5'

(i) I, WILLIAM E. WENFELER  
 (type or print name) certify that the corner location on this record was determined by me or under my direction and control and that this U.S. Public Land Survey Monument Record is correct and complete to the best of my knowledge and belief.

William E. Wengeler 17 Nov 88  
 Signature Date

RECEIVED BY THE COUNTY CLERK  
 COUNTY OF LINCOLN  
 WISCONSIN  
 INDEX NO. A-9