


State of Wisconsin }  
County of LINCOLN } ss.

I, William F. Kelly, do hereby certify that on the 15<sup>TH</sup> day of NOVEMBER, 1974, I found evidence of the EAST 1/4 corner of SECT 35 Township 34, North, Range R E, Fourth, Principal Meridian, as described hereon; and that from this evidence I established a new monument and accessories as described hereon to perpetuate the original location of this corner.

Resident witnesses:

RICHARD HANSON

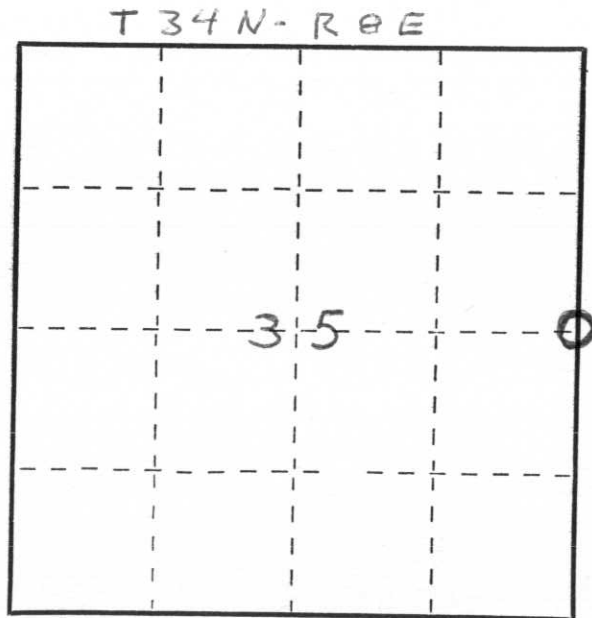

○ = Corner monument restored.

### CERTIFIED LAND CORNER RESTORATION

History of original corner establishment:

GRANITE MONUMENTS IN THIS AREA WERE SET IN THE 1920'S PER AREA RESIDENTS


Description of corner evidence found:

I FOUND A 6" x 6" GRANITE MONUMENT MARKED 35 + 36 AT FENCE INTERSECTION. CORNER IS IN A WET AREA.


I SET A NEW COUNTY MONUMENT 1 FT NORTH OF THE CORNER AND PLACED STONES AROUND THE MON.

Description of monument and accessories I established to perpetuate the original location of this corner.

NEW BEARING TREES BLAZED NBT CHEST HIGH AND MARKED WITH A + AT BASE

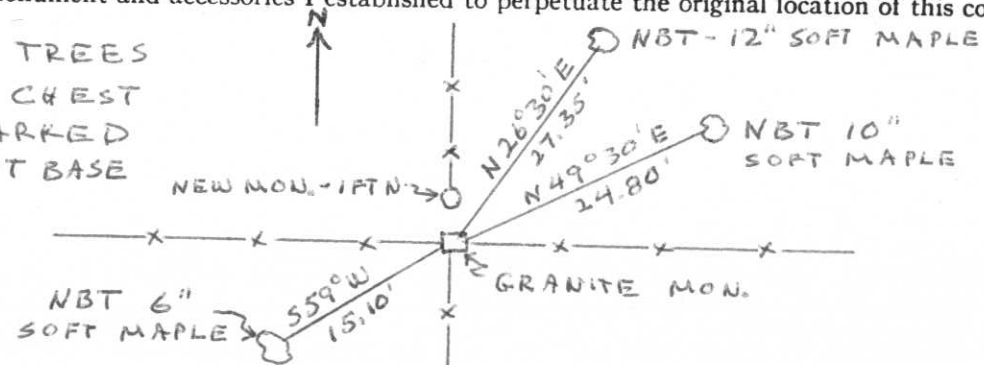

1/4 SECT COR  
35 + 36  
T 34 N - R 0 E  
COR 1 FT S  
WFK

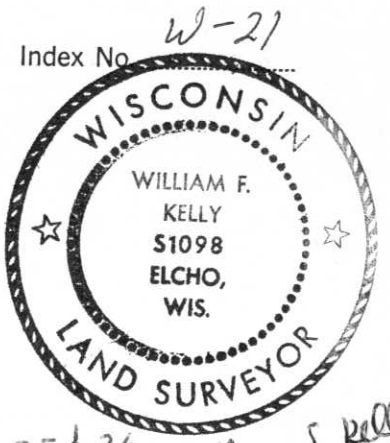

Dated at ELCHO, Wis., this 15<sup>TH</sup> day of NOVEMBER, 1974

Signature William F. Kelly Title REG. LAND SURVEYOR Registration No. S-1098  
(County Surveyor, Registered Land Surveyor, or other duly authorized official)

Office of Register of Deeds, County of \_\_\_\_\_, I hereby certify that the within instrument was filed in this office for record on the \_\_\_\_\_ day of \_\_\_\_\_, 19\_\_\_\_ at \_\_\_\_\_ o'clock \_\_\_\_\_ M.

(Register of Deeds)

By \_\_\_\_\_ Deputy