

CERTIFIED LAND CORNER RESTORATION

Index No. Y-1

State of Wisconsin }
County of LINCOLN } ss.

History of original corner establishment:

ORIGINAL GOVERNMENT SURVEY SET POST 1864 E.D. PALMER SURVEYOR
NO SUBSEQUENT RECORDS ON FILE

I WILLIAM IMMICH, do hereby certify that on the 27th day of SEPTEMBER, 19 82, I found evidence of the SOUTHWEST corner of SECTION 31 Township 35, North, Range 4 EAST, Fourth, Principal Meridian, as described hereon; and that from this evidence I established a new monument and accessories as described hereon to perpetuate the original location of this corner.

Description of corner evidence found:

RESET CORNER ON E.C.T.H. YY AND FENCELINE RUNNING WEST, CHECKED DISTANCE NORTH TO CREEK AND EAST TO SOUTH 1/4 CORNER SECTION 34. CORNER FIT GOOD, WAS BEST AVAILABLE EVIDENCE.


Resident witness



Description of monument and accessories I established to perpetuate the original location of this corner.

SET LINCOLN COUNTY MONUMENT STAMPED AS SHOWN.
BEARING TREES:

10" BALSAM S 38° W 124.00' PK IN BLAZE
9" BALSAM N 78° E 88.50' PK IN BLAZE
5" MAPLE S 49° E 81.90' PK IN BLAZE
POWER POLE S 86° W 44.97' NAIL IN SIDE

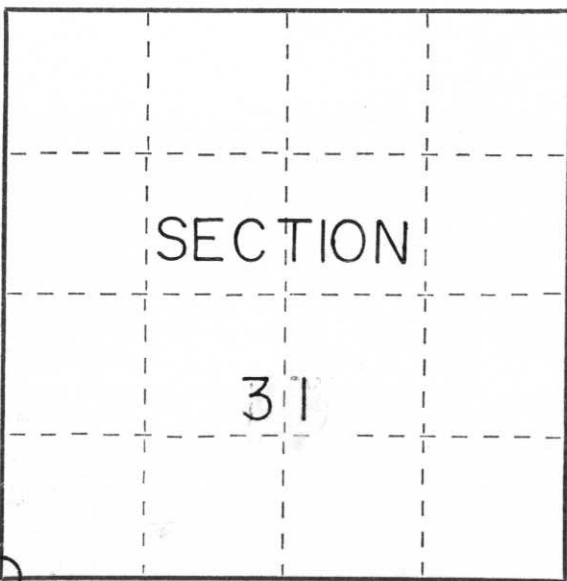

○ = Corner monument restored.

Dated at RHINELANDER, Wis., this 28th day of SEPTEMBER, 19 82.

Signature William Immich Title REGISTERED LAND SURVEYOR Registration No. 1383
(County Surveyor, Registered Land Surveyor, or other duly authorized official)

Office of Register of Deeds, County of _____, I hereby certify that the within instrument was filed in this office for record on the _____ day of _____, 19 _____ at _____ o'clock _____ M.

(Register of Deeds)

By _____ Deputy