


# U.S. PUBLIC LAND SURVEY MONUMENT RECORD

NOTE: THIS FORM IS INTENDED AND DESIGNED TO FULFILL ALL REQUIREMENTS OF WISCONSIN ADMINISTRATIVE CODE CHAPTER A-E 7.08 U.S. PUBLIC LAND SURVEY MONUMENT RECORD (3) (a)(b)(c)(d)(e)(f)(g)(h)(i). AN ADDITIONAL SHEET MAY BE ADDED IF NECESSARY TO CONFIRM WITH SAID REQUIREMENTS.

(a) CORNER LOCATION:  $\frac{N}{4}$  CORNER  
 SECTION 12, TOWNSHIP 35 NORTH, RANGE 4 EAST  
 TOWN OF SOMO, LINCOLN COUNTY  
 LINCOLN COUNTY COORDINATES:  
 NORTHING: 253802.151  
 EASTING: 330634.265  
 PREVIOUSLY MEASURED COORDINATES BY OTHERS  
 N: 253802.127  
 E: 330634.204

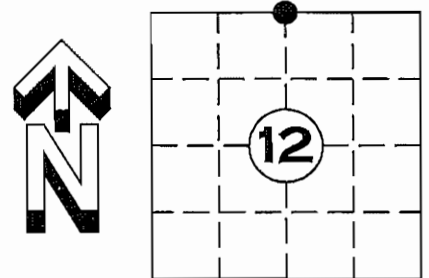


(b) HISTORY OF ORIGINAL CORNER:  
 ORIGINAL SURVEYOR: EDWARD D. PALMER APR. 1865 - MAY 1865  
 HEMLOCK 10 N 13° W 18 LINKS  
 BIRCH 16 S 10° E 21 LINKS

(f)(g)(h) DESCRIPTION OF MONUMENT FOUND AT THIS CORNER AND IF IT WAS ACCEPTED STATE ALL EVIDENCE (MATERIAL, TESTIMONIAL, OCCUPATIONAL, PLATS, RECORDS, OTHER MONUMENTS) USED AS A BASIS FOR ESTABLISHING LOCATION. IF REESTABLISHED THROUGH LOST CORNER PROPORTIONATE METHODS, INDICATE ALL MONUMENTS, DISTANCES, AND DIRECTIONS USED TO ESTABLISH. INDICATE TYPE OF MONUMENT AND SIGN POST FOUND OR SET.

28 SEPT... 1923: D.S. BURNETT SET AN IRON MONUMENT (D.S. BURNETT'S SURVEY NOTES OF T35N R4E PAGE 55)  
 7 FEBRUARY 2012: FOUND 4in. OD IRON PIPE WHICH IS CONSISTENT WITH THOSE SET BY D.S. BURNETT IN 1923. ACCEPTED LOCATION AND SET FOUR NEW WITNESS MONUMENTS.


(c)(d)(e) PLAN VIEW OF CORNER WITH TIES TO AT LEAST FOUR WITNESSES. IF IN DISAGREEMENT WITH PREVIOUSLY ESTABLISHED CORNER, SHOW THE DISTANCE BETWEEN THE TWO CORNERS AND ALSO INDICATED THE TIE TO THE DISPUTED CORNER.

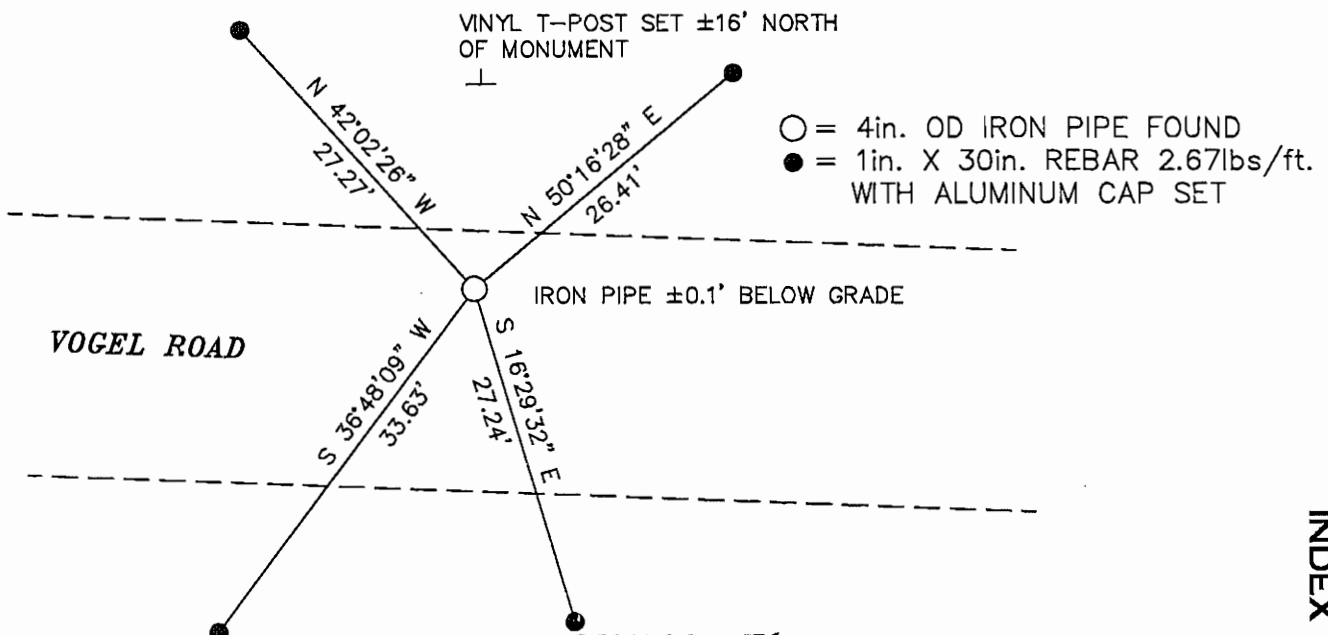

RECEIVED BY LINCOLN COUNTY  
 SURVEYOR THIS 10<sup>TH</sup> DAY  
 OF February 20, 12  
*Tom Dahn*  
 COUNTY SURVEYOR

I DARREN B. KRZANOWSKI, REGISTERED LAND SURVEYOR NO. 2663, HEREBY CERTIFY THAT THE CORNER LOCATION ON THIS RECORD WAS REFERENCED BY ME OR UNDER MY DIRECTION AND CONTROL AND THAT THIS U.S. PUBLIC LAND SURVEY MONUMENT RECORD IS COMPLETE TO THE BEST OF MY KNOWLEDGE AND BELIEF.

*Darren B. Krzanowski*  
 DARREN B. KRZANOWSKI RLS 2663  
 DATED THIS 9TH DAY OF FEBRUARY, 2012

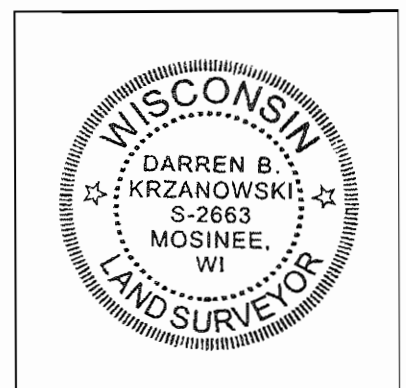

INDEX NO. T35N R4E E23





PLEASE DO NOT DISTURB HEAVY SURVEY





