


U.S. PUBLIC LAND SURVEY MONUMENT RECORD

NOTE: THIS FORM IS INTENDED AND DESIGNED TO FULFILL ALL REQUIREMENTS OF WISCONSIN ADMINISTRATIVE CODE CHAPTER A-E 7.08 U.S. PUBLIC LAND SURVEY MONUMENT RECORD (3) (a)(b)(c)(d)(e)(f)(g)(h)(i). AN ADDITIONAL SHEET MAY BE ADDED IF NECESSARY TO CONFIRM WITH SAID REQUIREMENTS.

(a) CORNER LOCATION: NW CORNER
 SECTION 12, TOWNSHIP 35 NORTH, RANGE 4 EAST
 TOWN OF SOMO, LINCOLN COUNTY
 LINCOLN COUNTY COORDINATES:
 NORTHING: 253914.045
 EASTING: 328016.444
 PREVIOUSLY MEASURED COORDINATES BY OTHERS
 N: 253913.985
 E: 328016.395

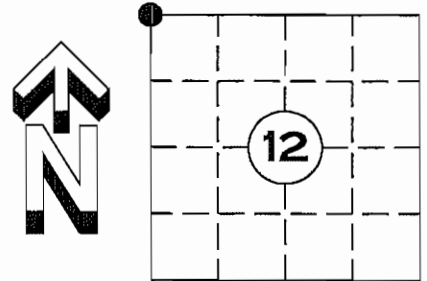


(b) HISTORY OF ORIGINAL CORNER:
 ORIGINAL SURVEYOR: EDWARD D. PALMER APR. 1865 - MAY 1865
 HEMLOCK 7 N 36° W 7 LINKS
 HEMLOCK 8 N 22° E 5 LINKS
 HEMLOCK 3 S 61° E 16 LINKS
 FIR S 10° W 25 LINKS

(f)(g)(h) DESCRIPTION OF MONUMENT FOUND AT THIS CORNER AND IF IT WAS ACCEPTED STATE ALL EVIDENCE (MATERIAL, TESTIMONIAL, OCCUPATIONAL, PLATS, RECORDS, OTHER MONUMENTS) USED AS A BASIS FOR ESTABLISHING LOCATION. IF REESTABLISHED THROUGH LOST CORNER PROPORTIONATE METHODS, INDICATE ALL MONUMENTS, DISTANCES, AND DIRECTIONS USED TO ESTABLISH. INDICATE TYPE OF MONUMENT AND SIGN POST FOUND OR SET.

21 SEPT., 1923: D.S. BURNETT FOUND A 2" X 2" X 18" IRON PIN, AND SET MONUMENT. (D.S. BURNETT SURVEY NOTES OF T35N R4E PAGE 37)

7 FEB., 2012: FOUND A 5" X 5" IRON PLATE ±1' BELOW GRADE THAT IS CONSISTENT WITH THOSE SET BY D.S. BURNETT IN 1923. ACCEPTED MONUMENT AND SET FOUR NEW WITNESS MONUMENTS.


(c)(d)(e) PLAN VIEW OF CORNER WITH TIES TO AT LEAST FOUR WITNESSES. IF IN DISAGREEMENT WITH PREVIOUSLY ESTABLISHED CORNER, SHOW THE DISTANCE BETWEEN THE TWO CORNERS AND ALSO INDICATED THE TIE TO THE DISPUTED CORNER.

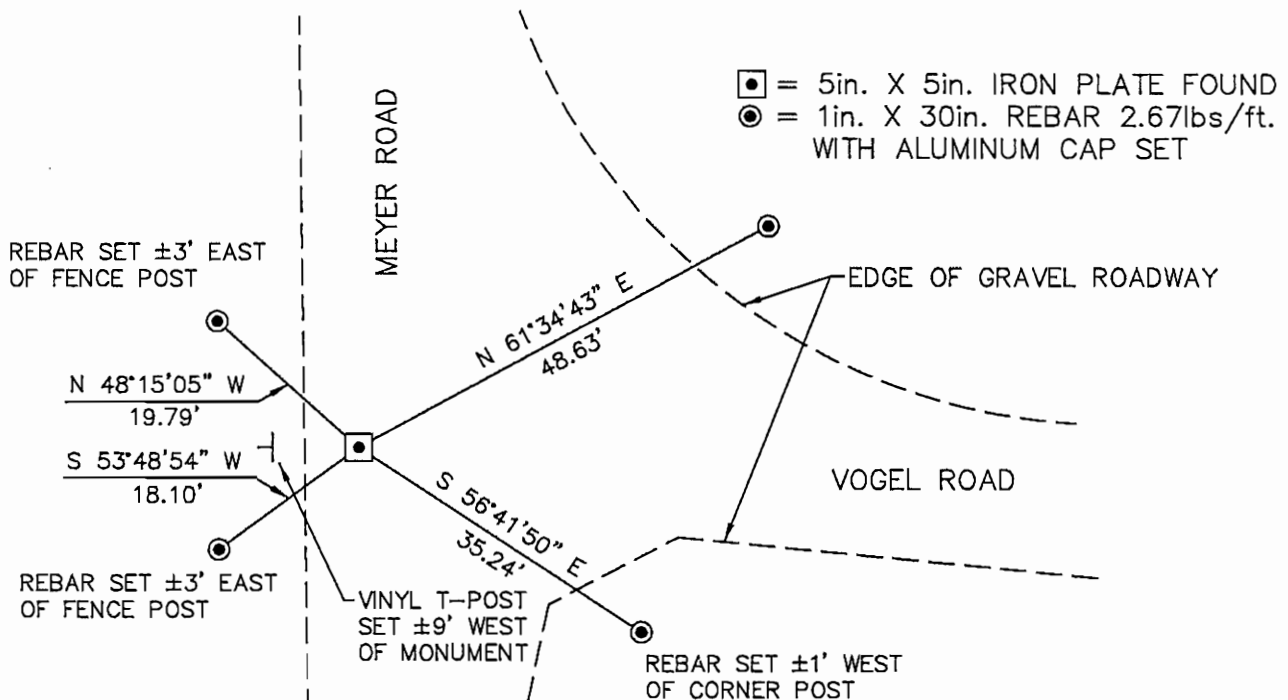

RECEIVED BY LINCOLN COUNTY SURVEYOR THIS 10TH DAY OF February 20 12
Tammy Dalk
 COUNTY SURVEYOR

I DARREN B. KRZANOWSKI, REGISTERED LAND SURVEYOR NO. 2663, HEREBY CERTIFY THAT THE CORNER LOCATION ON THIS RECORD WAS REFERENCED BY ME OR UNDER MY DIRECTION AND CONTROL AND THAT THIS U.S. PUBLIC LAND SURVEY MONUMENT RECORD IS COMPLETE TO THE BEST OF MY KNOWLEDGE AND BELIEF.

Darren B. Krzanowski
 DARREN B. KRZANOWSKI RLS 2663
 DATED THIS 8TH DAY OF FEBRUARY, 2012

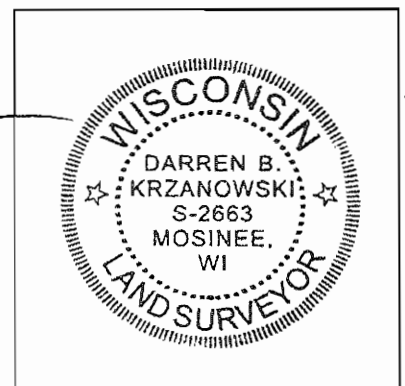

INDEX NO. T35N R4E E21









High Voltage Above
KEEP OFF

U.S.

