

CERTIFIED LAND CORNER RESTORATION


Index No. E-11

State of Wisconsin }
County of Lincoln } ss.

I Robert H. Winat, do hereby certify that on the 15 Dec. 1972 & 19 day of October, 1974, I found evidence of the South 1/4 corner of Section 4 Township 35, North, Range 4 East, Fourth, Principal Meridian, as described hereon; and that from this evidence I established a new monument and accessories as described hereon to perpetuate the original location of this corner.

Resident witnesses:

.....
.....
.....

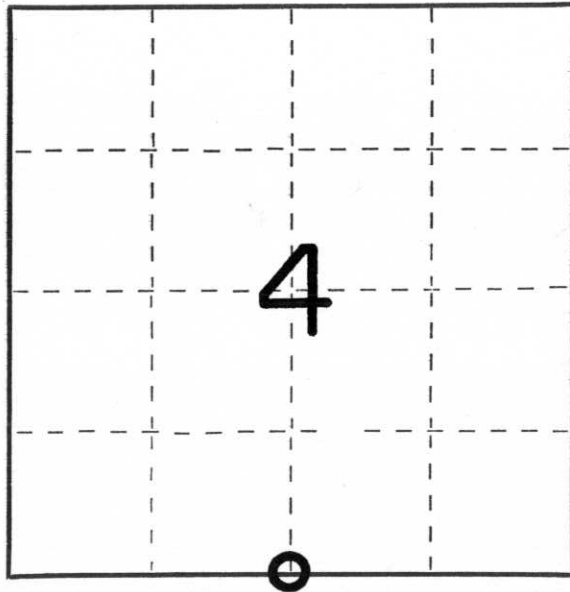

○ = Corner monument restored.

History of original corner establishment:

Edward D. Palmer
May 2, 1865
Wood post
13" Birch N26°E, 10 lk
14" Hemlock S15°W, 19 lk

Description of corner evidence found:

2" iron pipe with 4" x 6" sq. plate at 3 points of old stakes (2 cedar)
Burnett 1923
Humps at location of original BT's
Hump at Burnett's 16" Hemlock S49°E, 28 lks (18.5')
remains of 18" Birch S25°W, 41 lks (27.1') Burnett 1923
Fence line west and fence lines (old and new) north

Description of monument and accessories I established to perpetuate the original location of this corner.

Burnett's 2" IP with 4" x 6" plat set 1923 -piled rocks at base
Set post-made new BT's
PK and disc in 6" White Birch S61°E, 17.38'
6" White Birch S3°W, 22.48'
4" Triple maple N55°E, 51.04'
8" White Birch N17°E, 71.78'

Dated at Minneapolis, Wis., this 19th day of November, 1974.

Signature Robert H. Winat Title Land Surveyor Registration No. S-1040
(County Surveyor, Registered Land Surveyor, or other duly authorized official)

Office of Register of Deeds, County of....., I hereby certify that the within instrument was filed in this office for record on the.....day of....., 19..... at.....o'clock..... M..

.....
(Register of Deeds)

By.....Deputy