

# U.S. PUBLIC LAND SURVEY MONUMENT RECORD

Note: This form is intended and designed to fulfill all requirements of Wisconsin Administrative Code, Chapter A-E 5.02, U.S. Public Land Survey Monument Record (3) (a) (b) (c) (d) (e) (f) (g) (h) (l). An additional sheet may be added if necessary to conform with said requirements.

(a) Corner location: Township 35 North  
 Range 4 East  
 Town/City/Village SOMO  
 County Lincoln




Section 11

(b) (f) (g) (h) Description of monument found at this corner and if it was accepted, state all evidence (material, testimonial, occupational, plats, records, other monuments) used as a basis for accepting. If not accepted or if nothing was found, state evidence used as basis for establishing location. If reestablished through lost corner proportionate methods, indicate all monuments, distances and directions used to establish.

*The original corner was established by Palmer in 1865. Original bearing trees: 8" W. Pine, N33E, 50 lks.; 3" B. Alder, N10W, 8 lks. In September 1923, the corner was revisited by D.S. Burnett, where he found the original post left by Palmer and located the original W. Pine Bearing Tree. He kept this B.T. and established the following BT's: 14" S. Maple, S70W, 41 Lks.; 16" S. Maple, N45W, 48-1/2 Lks.; and 18" S. Elm, S70E, 51 lks. 12-1-99, William W. Nutter found a 5"x5" iron tablet on top of a 2" iron pipe set as the corner by the U.S. Forest Service from the late 1930's. Accepted this as the corner. No sign of Burnett's BT's. Established new BT's as shown below:*

(c) (d) (e) Plan view of corner with ties to at least 4 witness monuments. If in disagreement with previously established corner, show the distances between the two corners and also indicate the ties to the disputed corner.

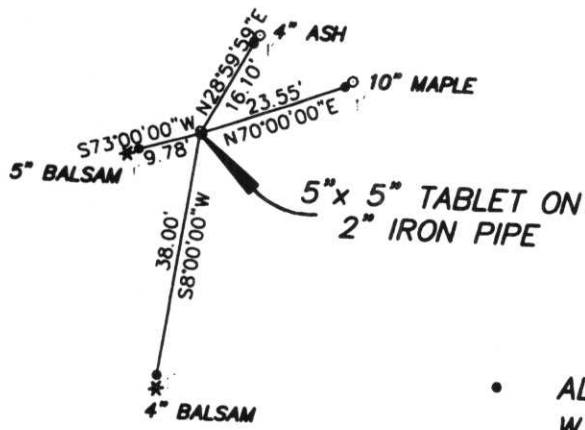

RECEIVED AT LINCOLN COUNTY  
 COURTHOUSE THIS 27th DAY  
 OF March 2000  
*Tony Dallman*  
 LAND INFORMATION OFFICE

(l) I, William W. Nutter, R.L.S., S-2299  
 (type or print name) certify that the corner location on this record was determined by me or under my direction and control and that this U.S. Public Land Survey Monument Record is correct and complete to the best of my knowledge and belief.  
William W. Nutter 3-24-2000  
 Signature Date