

CERTIFIED LAND CORNER RESTORATION

Index No. K-21

State of Wisconsin }  
County of Lincoln } ss.

I Robert H. Winat, do hereby certify that on the 28th day of December, 19 73, I found evidence of the East 1/4 corner of Section 14 Township 35, North, Range 4 East, Fourth, Principal Meridian, as described hereon; and that from this evidence I established a new monument and accessories as described hereon to perpetuate the original location of this corner.

Resident witnesses:

August Schotz  
\_\_\_\_\_  
\_\_\_\_\_

History of original corner establishment:


Edward D. Palmer  
April 22, 1865  
Wood post  
12" Cedar N75°W, 8 lks  
4" Cedar N23°E, 11 lks.

Description of corner evidence found:

2" iron pipe 30" long with plate on bottom (leaning northeasterly from road filling) - Burnett 1923  
Fits road centerline (extended) well  
Burnett had original N.E. BT, but evidence of this is not apparent (area burned over)

Description of ~~monument and~~ accessories I established to perpetuate the original location of this corner.

Straightened up Burnett's monument to fit his N.E. BT.  
PK/disc in 14" Spruce stump S52°W, 37.30'  
PK/disc in 10" Cedar stump N45°E, 15.30 (Burnett 1923)

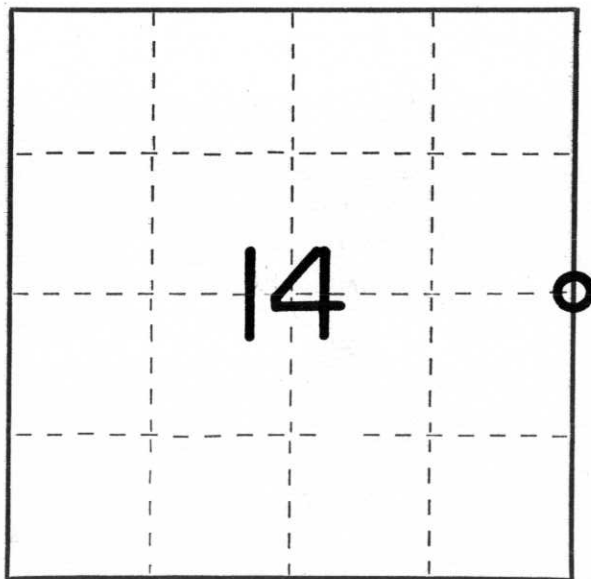

○ = Corner monument restored.

Dated at Minosqua, Wis., this 19th day of November, 1974.

Signature Robert H. Winat Title Land Surveyor Registration No. S-1040  
(County Surveyor, Registered Land Surveyor, or other duly authorized official)

Office of Register of Deeds, County of \_\_\_\_\_, I hereby certify that the within instrument was filed in this office for record on the \_\_\_\_\_ day of \_\_\_\_\_, 19 \_\_\_\_\_ at \_\_\_\_\_ o'clock \_\_\_\_\_ M.

\_\_\_\_\_  
(Register of Deeds)

By \_\_\_\_\_ Deputy









