

U.S. PUBLIC LAND SURVEY MONUMENT RECORD


Note: This form is intended and designed to fulfill all requirements of Wisconsin Administrative Code, Chapter A-E 5.02, U.S. Public Land Survey Monument Record (3) (a) (b) (c) (d) (e) (f) (g) (h) (i). An additional sheet may be added if necessary to conform with said requirements.

(a) Corner location: Township 35 North

Range 4 East

Town/~~City/Village~~ Somo

County Lincoln

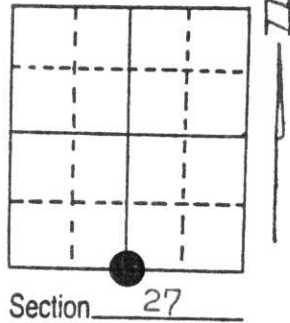

Section 27

(b) (f) (g) (h) Description of monument found at this corner and if it was accepted, state all evidence (material, testimonial, occupational, plats, records, other monuments) used as a basis for accepting. If not accepted or if nothing was found, state evidence used as basis for establishing location. If reestablished through lost corner proportionate methods, indicate all monuments, distances and directions used to establish. Original Gov't. Survey: Apr. 1865 by Edward Palmer, set wood post for corner with bearings, spruce 7 N 15° W 10 links & spruce 4 S 23° E 18 links. On 25 Oct 95, the Lincoln County Highway Department gradeall was used to dig in County Trunk Highway "T" to locate evidence of this corner. The roadbed makes a definite bend at the approximate corner location. Excavation was made to below the corduroy, into the native swamp material. No evidence of the corner was found and no corner was reestablished.

(c) (d) (e) Plan view of corner with ties to at least 4 witness monuments. If in disagreement with previously established corner, show the distances between the two corners and also indicate the ties to the disputed corner.

RECEIVED AT LINCOLN COUNTY
COURTHOUSE THIS 14th DAY
OF December 19 95
Pat Probe
TAX DESCRIPTION OFFICE

(i) I, Lester J. Schmit
(type or print name) certify that the corner location on this record was determined by me or under my direction and control and that this U.S. Public Land Survey Monument Record is correct and complete to the best of my knowledge and belief.

Lester J. Schmit 11 Dec 95
Signature Date



Index No. U-15