

# LINCOLN COUNTY U.S. PUBLIC LAND SURVEY MONUMENT LOCATION RECORD

SECTION 3  
TOWNSHIP 34N  
RANGE 4E

**A13**  
NO.

LANDMARK       BENCHMARK \_\_\_\_\_  
CORNER IDENTITY: BERNTSEN MONUMENT

FOUND   
SET   
RESET   
RE-TIED


LINCOLN COUNTY COORDINATE: N: \_\_\_\_\_  
E: \_\_\_\_\_

ELEVATION-(FEET): \_\_\_\_\_ DATUM: \_\_\_\_\_

WEATHER: CLEAR AND SUNNY

DATE OF SURVEY: 6/26/2018 TEMPERATURE: 75 °F

SURVEY PARTY: AUSTIN PELOT & GUNNER GRENLIE

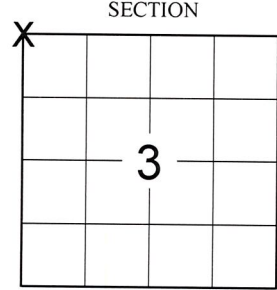

LOCATION  
(Indicated By X)



## BASIS FOR MONUMENT LOCATION:

(DESCRIBE METHOD OF SURVEY AND CORNER AUTHENTICATION)

SEARCHED FOR NORTHWEST CORNER OF SECTION 3 AND FOUND 2-1/2" O.D. IRON PIPE WITH CAP LEANING AND BENT BEYOND RECOVERY. LOCATED BASE OF IRON PIPE WHICH MATCHED WITHIN REASON THE COORDINATES PROVIDED ON SECTION SUMMARY (SECTION 34/35N/R4E, TOWN OF SOMO, S-2663, 2012). HELD PROVIDED COORDINATES AS BEST AVAILABLE EVIDENCE FOR THE ORIGINAL POSITION OF THE FOUND MONUMENT. SET BERNTSEN MONUMENT WITH FOUR NEW TIES TO PERPETUATE THIS CORNER LOCATION AS SHOW BELOW.



FIELD BOOK NO. NA PAGE NO. NA


COMPANY RIVERSIDE LAND SURVEYING LLC

CERTIFIED CORRECT:

*Nathan J. Wincentsen*  
NATHAN J. WINCENTSEN S-2539  
Professional Land Surveyor  
DATE: 6-28-18

## TIE SKETCH:

- SET BERNTSEN MONUMENT
- SET 3/4" REBAR WITH CAP
- SET VINYL "T" POST

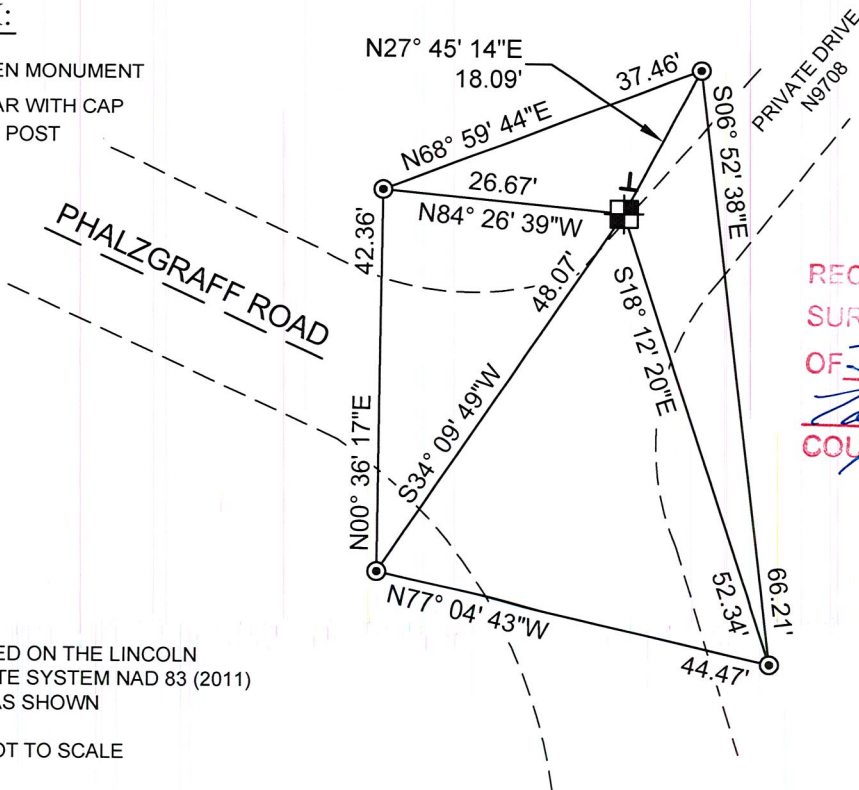

RECEIVED BY LINCOLN COUNTY  
SURVEYOR THIS 5<sup>TH</sup> DAY  
OF July 20 18  
*Jerry Duth*  
COUNTY SURVEYOR

BEARINGS ARE BASED ON THE LINCOLN COUNTY COORDINATE SYSTEM NAD 83 (2011) AND REFERENCED AS SHOWN

THIS DRAWING IS NOT TO SCALE

**A13**  
NO.