


# U. S. PUBLIC LAND SURVEY MONUMENT RECORD

Note: This form is intended and designed to fulfill all requirements of Wisconsin Administrative Code-Chapter A-E 7.08 U. S. Public Land Survey Monument Record (3)(a)(b)(c)(d)(e)(f)(g)(h)(i). An additional sheet may be added if necessary to conform with said requirements.

(a) CORNER LOCATION: State Plane Coordinates  
 E. Meander corner of Sec. 8 X \_\_\_\_\_  
 Township 35 North Y \_\_\_\_\_  
 Range 5 East Datum Base \_\_\_\_\_  
 Town Wilson County of Lincoln

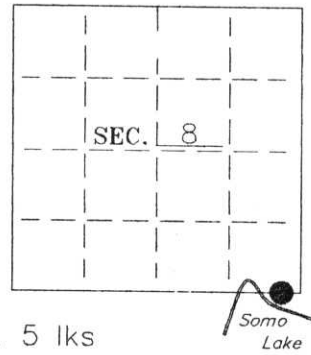

(b) HISTORY OF ORIGINAL CORNER ESTABLISHMENT:  
 Original Surveyor: James Millard  
 Date of Survey: Commenced 1860  
 Completed 1860


Original B.T.'S  
 W. Pine 8" N24°W, 5 lks  
 Y. Pine 9" S17°E, 5 lks

(b)(f)(g)(h) Description of monument found at this corner and if it was accepted—state all evidence (material—testimonial—occupation—plats—records—other monuments) used as a basis for accepting. If not accepted or if nothing was found state evidence used as basis for establishing location. If reestablished through lost corner proportionate methods indicate all monuments—distances and directions used to establish. Indicate type of monument and sign post found or set.

1979— A map by James Kasson shows he found a 1" iron pipe on the east shore of Somo Lake.

2001— I found and accepted a 1/2" iron pipe on the east shore of Somo Lake and replaced it with a 1-1/4" iron rod. The corner falls ±11' east and ±25' north of high water mark. I made 4 new BT's as shown below.

(c)(d)(e) Plan view of corner with ties to at least 4 witness monuments. If in disagreement with previously established corner—show the distances between the two corners and also indicate the ties to the disputed.

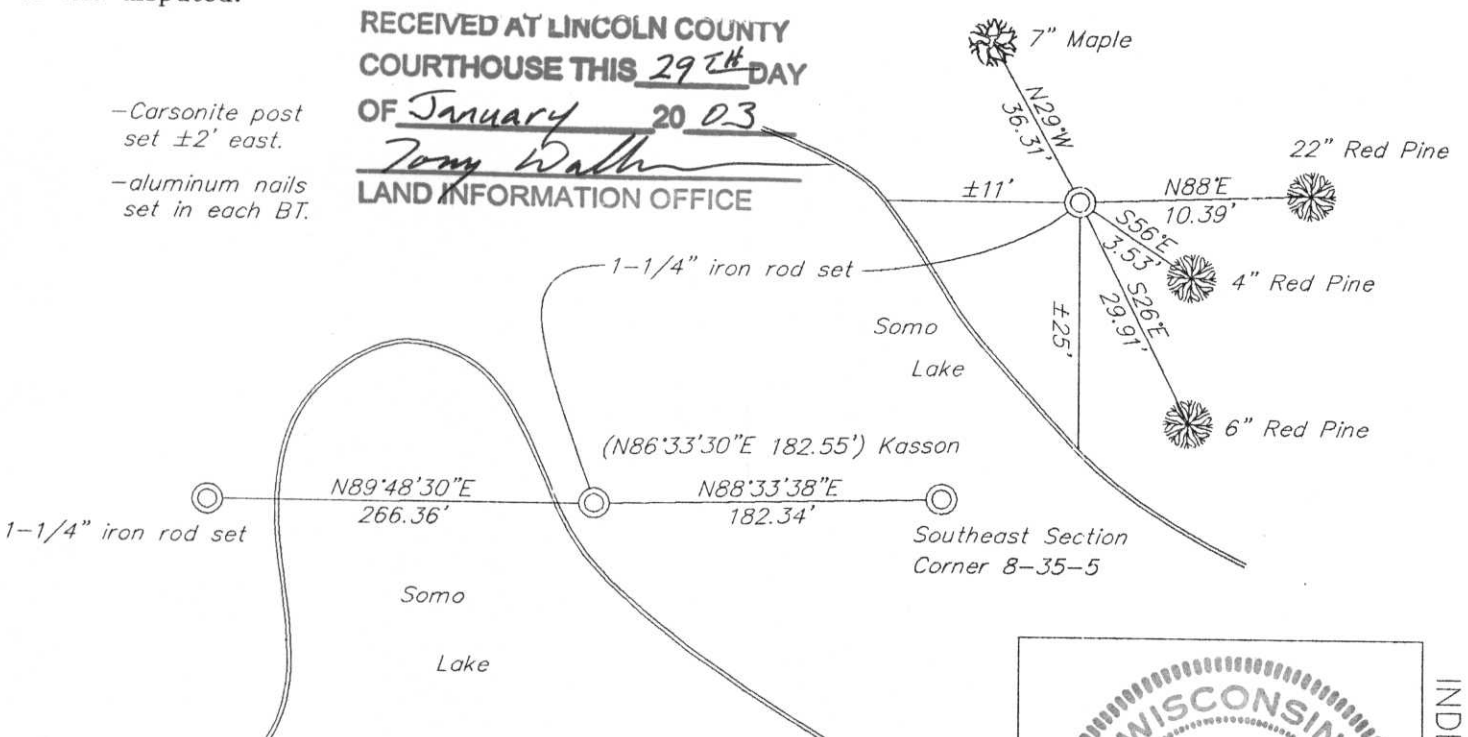

-Carsonite post set ±2' east.  
 -aluminum nails set in each BT.

RECEIVED AT LINCOLN COUNTY  
 COURTHOUSE THIS 29<sup>TH</sup> DAY  
 OF January 20 03  
 Tony Walk  
 LAND INFORMATION OFFICE



INDEX NO. I-98

(i) I Stuart L. Foltz S-1170 hereby certify that the corner location on this record was determined by me or under my direction and control and that this U.S. Public Land Survey Monument Record is correct and complete to the best of my knowledge and belief.

Signature Stuart L. Foltz Date 1/23/03