

CERTIFIED LAND CORNER RESTORATION

Index No. MN-13

State of Wisconsin }  
County of Lincoln } ss.

History of original corner establishment:

Surveyor: Joseph H. Jenkins  
Date: October 1862  
Monumentation: Wood Post  
Witnesses: White pine 12, N 51° W, 10 links  
Yellow pine 12, S 42° E, 28 links

I Lester J. Schmit, do hereby certify that on the 6th day of October, 1978, I found evidence of the Meander corner ~~at~~ between Sections 21 & 22, Township 35, North, Range 5 East, Fourth, Principal Meridian, as described hereon; and that from this evidence I established a new monument and accessories as described hereon to perpetuate the original location of this corner.

Description of corner evidence found:

1" iron pipe, 5" above the surface, 5 feet north the shore of Somo Lake.


Resident witnesses:

.....  
.....  
.....

Description of monument and accessories I established to perpetuate the original location of this corner.

Set Berntsen monument to replace iron pipe as corner. Witnesses with:

- P.K. Nail in 4" soft maple, N 05° E, 4.46'
- P.K. Nail in 6" white birch, S 40° W, 14.87'
- P.K. Nail in 7" soft maple, S 29° E, 13.45'
- P.K. Nail in 16" norway pine, N 71° W, 20.94'

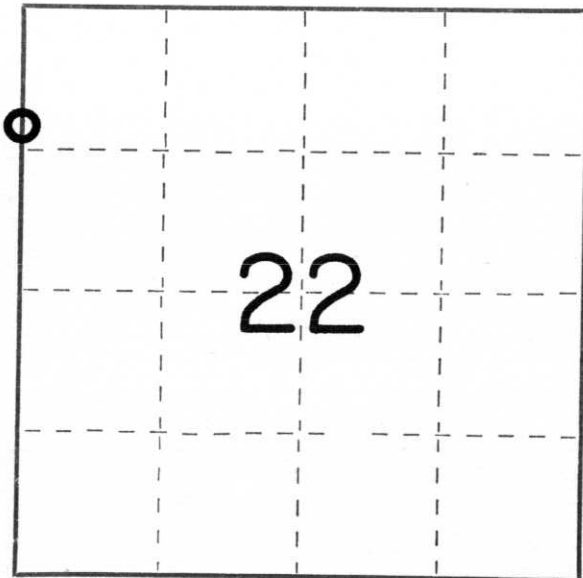

○ = Corner monument restored.

Dated at Tomahawk, Wis., this 2nd day of September, 1981.

Signature Lester J. Schmit Title Land Surveyor Registration No. S 1192  
(County Surveyor, Registered Land Surveyor, or other duly authorized official)

Office of Register of Deeds, County of....., I hereby certify that the within instrument was filed in this office for record on the..... day of....., 19..... at..... o'clock..... M.

.....  
(Register of Deeds)

By..... Deputy