

CERTIFIED LAND CORNER RESTORATION


Index No. Q-17

State of Wisconsin }
County of Lincoln } ss.

I Lester J. Schmit, do hereby certify that on the 9th day of November, 1984, I found evidence of the Northeast corner of Section 27 Township 35, North, Range 5 East, Fourth, Principal Meridian, as described hereon; and that from this evidence I established a new monument and accessories as described hereon to perpetuate the original location of this corner.

Resident witnesses:

.....
.....
.....

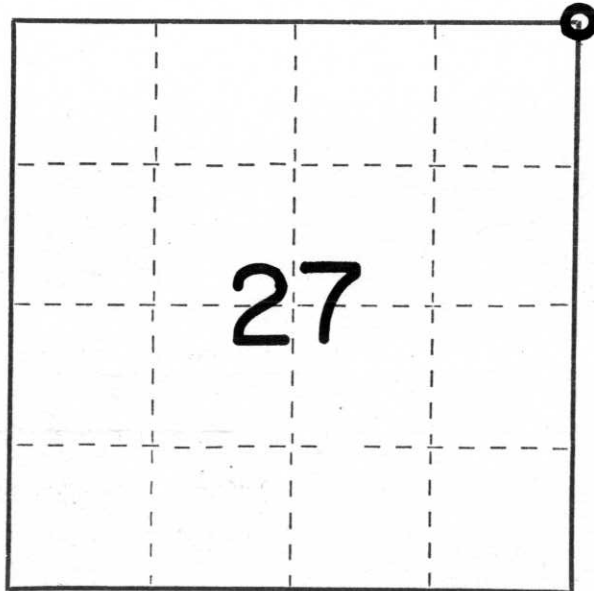

○ = Corner monument restored.

History of original corner establishment:

Surveyor: Joseph W. Jenkins
Date: 26 September 1862
Monumentation: Wood Post
Witnesses: Black Pine 8, S 7° W, 248 links
Yellow Pine 10, S 3° E, 230 links
Yellow Pine 16, N 4° E, 443 links
White Pine 14, N 2° W, 447 links

Description of corner evidence found: Found post point in wet, open swamp, for the corner. Top of post was rotted off and the upper portion of the post could not be found.

Description of monument and accessories I established to perpetuate the original location of this corner.

Set Berntsen monument for the corner to replace post point. Mounded sand & a couple of rock around the Berntsen to stabilize it. Pushed post point into swamp 1.5' east of actual corner. See reverse side for diagram.

Witnessed by: 5" black spruce, N 58° E, 29.98'
6" tamarack, S 88° E, 66.28'
8" norway pine, S 41° W, 86.35'
12" white pine, N 35° W, 145.70'

Dated at Tomahawk, Wis., this 11th day of November, 1984

Signature Lester J. Schmit Title Land Surveyor Registration No. S-1192
(County Surveyor, Registered Land Surveyor, or other duly authorized official)

Office of Register of Deeds, County of....., I hereby certify that the within instrument was filed in this office for record on the.....day of....., 19..... at.....o'clock..... M.

.....
(Register of Deeds)

By.....Deputy