

CERTIFIED LAND CORNER RESTORATION

Index No. U-21

State of Wisconsin }
County of Lincoln } ss.

History of original corner establishment: **Surveyor: Joseph W. Jenkins**
Monumentation: Wood Post
Witnesses: Yellow Pine 12 N 86° W 17 links
White Pine 10 S 77° W 43 links
Aspen 8 S 72° E 16 links
Yellow Pine 14 N 33° E 29 links

Date: October 1862

I Lester J. Schmit, do hereby certify that on the 22nd day of March, 1975, I found evidence of the Southeast corner of Section 26 Township 35, North, Range 5 East, Fourth, Principal Meridian, as described hereon; and that from this evidence I established a new monument and accessories as described hereon to perpetuate the original location of this corner.


Description of corner evidence found: **2" x 48" Iron Pipe, 18" below surface of Town Road.**
Witnesses: 8" Spruce S 56° E, 80.0'
9" Jack Pine Stump S 42° W, 55.0'

Resident witnesses:

Description of monument and accessories I established to perpetuate the original location of this corner.

Berntsen Monument - 30" (set 3" below the surface of the Town Road)

P.K. Nail in 12" White Pine S 48° W, 44.49'
P.K. Nail in Power Pole N 50° W, 23.31'
P.K. Nail in 8" Norway Pine N 22° E, 72.78'

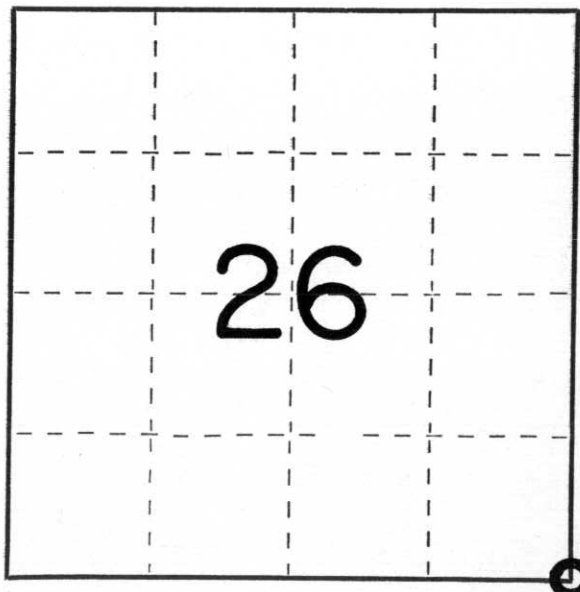

○ = Corner monument restored.

Dated at Rhineland, Wis., this 15th day of November, 1975.

Signature Lester J. Schmit Title Land Surveyor Registration No. S-1192
(County Surveyor, Registered Land Surveyor, or other duly authorized official)

Office of Register of Deeds, County of _____, I hereby certify that the within instrument was filed in this office for record on the _____ day of _____, 19____ at _____ o'clock _____ M.

(Register of Deeds)

By _____ Deputy